

MISSISSIPPI DEPARTMENT OF NATURAL RESOURCES

Bureau of Land and Water Resources

Southport Mall

P.O. Box 10631

Jackson, Mississippi 39209

WATER WELL DRILLERS LOG

J 206A
 PILE
 9-5-85

9-5 19 85 H. S. S. S. S. S. S. Pike
 date well completed firm name county well located

LANDOWNER:
HAZEL FERENCE
RR. 2 mcb, ms.
 (mailing address)

description of formations encountered	from to	
<u>Red clay</u>	<u>0</u>	<u>20</u>
<u>Red sand</u>	<u>20</u>	<u>125</u>
<u>Coarse sand & gravel</u>	<u>125</u>	<u>140</u>

WELL LOCATION:
 sec. 8 T. 2 N. R. 9 E
 S W
7 miles E of mcb
 (distance) (direction) (nearest town)

WELL PURPOSE: Home
 (home, irrigation, municipal, industrial)

WELL COMPLETION DATA:

(1) diameter (inches) 4

(2) total depth (feet) 140

(3) static water level (feet) 100 below above top of ground.

(4) casing PVC, 130,
 (material) (depth)
4 if telescope see back.
 (size)

(5) screen 10, 130
 (length) (depth to top)
4, PVC
 (size) (material)

(6) pump 1/2, 10
 (HP) (yield gpm)
Electric
 (type power)

(7) electric log No
 (yes or no)
 (organization running log)


(8) how well bottom plugged Sealed

DRILLERS REMARKS:

RECEIVED
 SEP 13 1985
 Department of Natural Resources
 Bureau of Land & Water

If well telescopes please sketch and show depths.

GROUND LEVEL

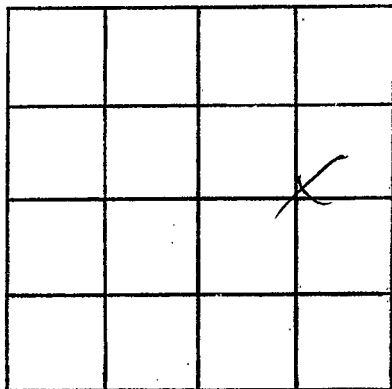

SECTION 8

Please indicate well location X.

ADDITIONAL INFORMATION

If more than one screen,
show locations of each on sketch.