

MISSISSIPPI DEPARTMENT OF NATURAL RESOURCES

Bureau of Land and Water Resources

Southport Mall

P.O. Box 10631

Jackson, Mississippi 39209

WATER WELL DRILLERS LOG

J 2070
PIKE
8-14-85

8-14 1985 Fitzgerald Well Serv Pike
 date well completed firm name county well located

LANDOWNER:	description of formations encountered	from	to
		<u>Marline Harris</u>	
<u>R.R. 2 m. Colby, Mo.</u> (mailing address)	<u>Red Clay</u>	<u>0</u>	<u>20</u>
	<u>Red Sand</u>	<u>20</u>	<u>140</u>
	<u>Course sand & gravel</u>	<u>140</u>	<u>155</u>

WELL LOCATION:
 sec. 9 T 2 N R 9 E
 S W
1 1/2 miles S of Barco
 (distance) (direction) (nearest town)

WELL PURPOSE: Home
 (home, irrigation, municipal, industrial)

- WELL COMPLETION DATA:
- (1) diameter (inches) 4
 - (2) total depth (feet) 155
 - (3) static water level (feet) 115 below above top of ground.
 - (4) casing PVC, 145,
(material) (depth)
4 if telescope see back.
(size)
 - (5) screen 10, 145
(length) (depth to top)
4, PVC
(size) (material)
 - (6) pump 1/2, 10
(HP) (yield gpm)
ah
(type power)
 - (7) electric log no
(yes or no)
(organization running log)
 - (8) how well bottom plugged Sand plug

DRILLERS REMARKS:


RECEIVED

SEP 13 1985

Department of Natural Resources
 Bureau of Land & Water Resources

If well telescopes please
sketch and show depths.

GROUND LEVEL

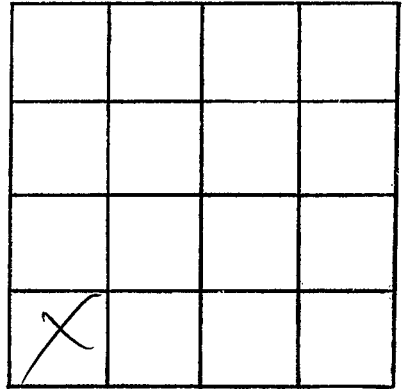

SECTION 9

Please indicate well location X.

ADDITIONAL INFORMATION

If more than one screen,
show locations of each on sketch.