

MISSISSIPPI DEPARTMENT OF NATURAL RESOURCES

Bureau of Land and Water Resources

Southport Mall

P.O. Box 10631

Jackson, Mississippi 39209

WATER WELL DRILLERS LOG

JACKSON
PIKE
7-23-85

7-23 1985 Fitzgerald Well Service Pike
date well completed firm name county well located


LANDOWNER:
Bennie James
R.R. 2 m'eb -
(mailing address)

description of formations encountered	from	to
<u>Red Clay</u>	<u>0</u>	<u>20</u>
<u>Red Sand</u>	<u>20</u>	<u>80</u>
<u>Red Silt</u>	<u>80</u>	<u>125</u>
<u>Coarse Sand & Gravel</u>	<u>125</u>	<u>140</u>

WELL LOCATION:
sec. 6 T 2 N R 9 E
S W
8 miles E of m'eb
(distance) (direction) (nearest town)

WELL PURPOSE: Home
(home, irrigation, municipal, industrial)

- WELL COMPLETION DATA:
- (1) diameter (inches) 4
 - (2) total depth (feet) 140
 - (3) static water level (feet) 95 below above top of ground.
 - (4) casing PVC, 130,
(material) (depth)
4 if telescope see back.
(size)
 - (5) screen 10, 130
(length) (depth to top)
4, PVC
(size) (material)
 - (6) pump 1/2, 10
(HP) (yield gpm)
600
(type power)
 - (7) electric log no
(yes or no)
(organization running log)

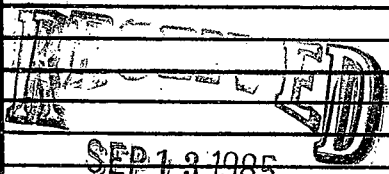

SEP 13 1985


Department of Natural Resources
Bureau of Land and Water Resources

(8) how well bottom plugged: Sand Shkr

DRILLERS REMARKS:

If well telescopes please sketch and show depths.

GROUND LEVEL

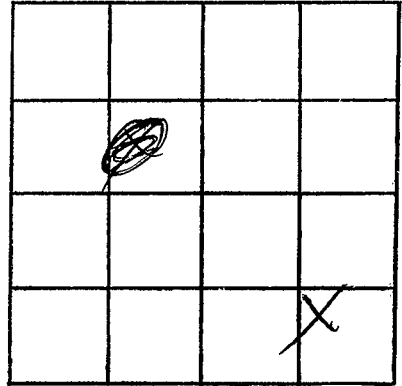

SECTION 6

Please indicate well location X.

ADDITIONAL INFORMATION

If more than one screen,
show locations of each on sketch.