

PIKE
S
2003

MISSISSIPPI DEPARTMENT OF NATURAL RESOURCES
Bureau of Land and Water Resources
Southport Mall
P.O. Box 10631
Jackson, Mississippi 39209
WATER WELL DRILLERS LOG

6-26 1986 *St. Ignace Well* *Pike*
date well completed firm name county well located

LANDOWNER:
Charles Lanier
RR 2, M'Comb
(mailing address)

description of formations encountered	from	to
<i>Red clay</i>	<i>0</i>	<i>20</i>
<i>Red sand</i>	<i>20</i>	<i>125</i>
<i>Coarse sand & gravel</i>	<i>125</i>	<i>137</i>

WELL LOCATION:
sec. *7* T *2* N R *9* E
S W
8 miles *E* of *M'Comb*
(distance) (direction) (nearest town)

WELL PURPOSE: *Home*
(home, irrigation, municipal, industrial)

- WELL COMPLETION DATA:
- (1) diameter (inches) *4*
 - (2) total depth (feet) *137*
 - (3) static water level (feet) *85* below top of ground.
 - (4) casing *PVC, 127*, (depth)
4 if telescope see back.
(size)
 - (5) screen *10, 127*
(length) (depth to top)
4, *PVC*
(size) (material)
 - (6) pump *1/2, 10*
(HP) (yield gpm)
Elex
(type power)
 - (7) electric log *No*
(yes or no)
(organization running log)
 - (8) how well bottom plugged *Sam D...*


RECEIVED
JUL 21 1986

Department of Natural Resources
Bureau of Land & Water Resources

DRILLERS REMARKS:

If well telescopes please sketch and show depths.

GROUND LEVEL

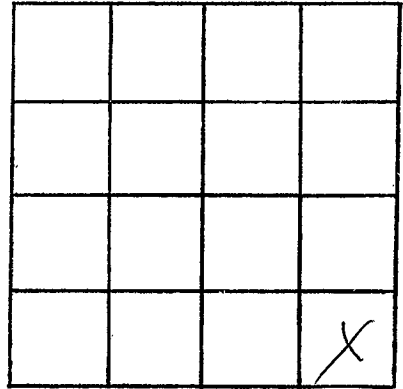

SECTION 2

Please indicate well location X.

ADDITIONAL INFORMATION

If more than one screen,
show locations of each on sketch.