

PIKE  
J  
2074

MISSISSIPPI DEPARTMENT OF NATURAL RESOURCES  
Bureau of Land and Water Resources  
Southport Mall  
P.O. Box 10631  
Jackson, Mississippi 39209  
WATER WELL DRILLERS LOG


5-6 1986 Fitzgerald Well Sew Pike  
date well completed firm name county well located

LANDOWNER:	description of formations encountered	from	to
<u>Royce Williams</u> <u>RR-2, McComb, ms.</u> (mailing address)			
WELL LOCATION:			
sec. <u>3</u> T <u>2</u> N R <u>9</u> E S W			
<u>9</u> miles <u>E</u> of <u>McComb</u> (distance) (direction) (nearest town)			
WELL PURPOSE:			
(home, irrigation, municipal, industrial) <u>Home</u>			
WELL COMPLETION DATA:			
(1) diameter (inches) <u>4</u>			
(2) total depth (feet) <u>124</u>			
(3) static water level (feet) <u>6</u> below above top of ground.			
(4) casing <u>POC</u> , <u>114</u> , (material) (depth) <u>4</u> (size) if telescope see back.			
(5) screen <u>10</u> , <u>114</u> (length) (depth to top) <u>4</u> , <u>POC</u> (size) (material)			
(6) pump <u>1/2</u> , <u>10</u> (HP) (yield gpm) <u>Electric</u> (type power)			
(7) electric log <u>no</u> (yes or no) <u>Elco</u> (organization running log)			
(8) how well bottom plugged <u>Sand fill</u>			
DRILLERS REMARKS:			

RECEIVED  
MAY 28 1986  
DEPARTMENT OF NATURAL RESOURCES  
BUREAU OF LAND & WATER RESOURCES

If well telescopes please sketch and show depths.

GROUND LEVEL

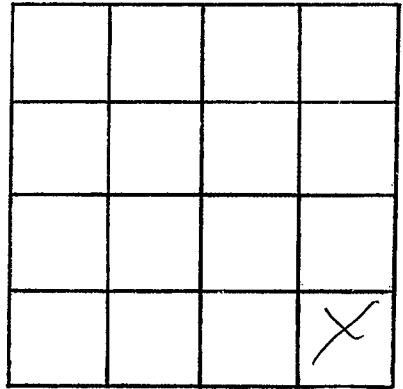

SECTION 3

Please indicate well location X.

ADDITIONAL INFORMATION

If more than one screen,  
show locations of each on sketch.