

MISSISSIPPI DEPARTMENT OF NATURAL RESOURCES

Bureau of Land and Water Resources

Southport Mall

P.O. Box 10631

Jackson, Mississippi 39209

WATER WELL DRILLERS LOG

Pike
J
2076

2-18

date well completed

1986 Fitzgibbon Well Serv

firm name

Pike

county well located

LANDOWNER:

Ray Hawley

RD 2, McComb, Ms.
(mailing address)

description of formations encountered

from

to

<u>Clay</u>	<u>0</u>	<u>10</u>
<u>Sand & gravel</u>	<u>10</u>	<u>24</u>
<u>White & blue chalk</u>	<u>24</u>	<u>160</u>
<u>Coarse sand</u>	<u>160</u>	<u>180</u>

WELL LOCATION:

sec. 3 T. 2 N. R. 9 E
S. W.
8 miles E of McComb
(distance) (direction) (nearest town)

WELL PURPOSE:

Home
(home, irrigation, municipal, industrial)

WELL COMPLETION DATA:

- (1) diameter (inches) 4
- (2) total depth (feet) 180
- (3) static water level (feet) 10 below above top of ground.
- (4) casing 4" PUL (material), 170 (depth),
4 if telescope see back.
(size)
- (5) screen 10 (length), 170 (depth to top)
4 (size), PUL (material)
- (6) pump 3/4 (HP), 15 (yield gpm)
Electric (type power)
- (7) electric log No (yes or no)
(organization running log)
- (8) how well bottom plugged Sand check

RECEIVED


MAR 13 1986

Department of Natural Resources
Bureau of Land & Water Resources

DRILLERS REMARKS:

If well telescopes please
sketch and show depths.

GROUND LEVEL

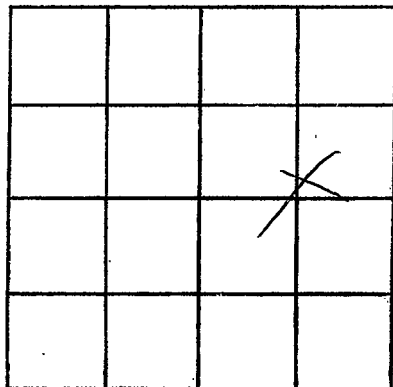

SECTION 3

Please indicate well location X.

ADDITIONAL INFORMATION

If more than one screen,
show locations of each on sketch.