

MISSISSIPPI DEPARTMENT OF NATURAL RESOURCES

Bureau of Land and Water Resources

Southport Mall

P.O. Box 10631

Jackson, Mississippi 39209

WATER WELL DRILLERS LOG

PIKE
J
209

1-16 date well completed

1986 Feb 10 firm name

Pike county well located


LANDOWNER:	description of formations encountered	from	to
Jim Estes			
R.B. 2, McComb (mailing address)	Red sand & gravel	20	155
	Coarse sand & gravel	155	170

WELL LOCATION:  
 sec. 17 T 2 N R 9 E  
                     S                    W  
 1/2 miles W of Leggett  
 (distance) (direction) (nearest town)

WELL PURPOSE: Home  
 (home, irrigation, municipal, industrial)

- WELL COMPLETION DATA:
- (1) diameter (inches) 4
  - (2) total depth (feet) 170
  - (3) static water level (feet) 85 below top of ground.
  - (4) casing PVC 160 (material), (depth)  
4 (size) if telescope see back.
  - (5) screen 10 160 (length), (depth to top)  
4 (size), PVC (material)
  - (6) pump 1 20 (HP), (yield gpm)  
Elec (type power)
  - (7) electric log No (yes or no)
  - (organization running log)
  - (8) how well bottom plugged Sand Shale

DRILLERS REMARKS:

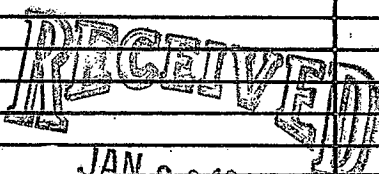


JAN 30 1986

Department of Natural Resources  
Bureau of Land & Water Resources

If well telescopes please sketch and show depths.

GROUND LEVEL

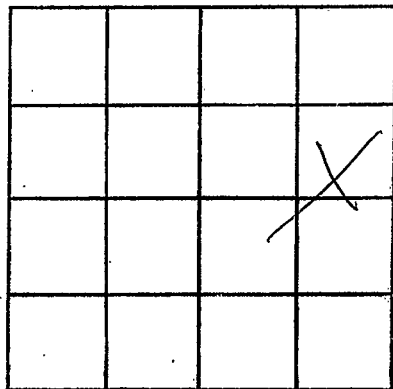

SECTION 17

Please indicate well location X.

ADDITIONAL INFORMATION

If more than one screen, show locations of each on sketch.