

MISSISSIPPI DEPARTMENT OF NATURAL RESOURCES

Bureau of Land and Water Resources

Southport Mall

P.O. Box 10631

Jackson, Mississippi 39209

WATER WELL DRILLERS LOG

Pike
J
2078

1-2 1986 Fitzgerald Well Drilling Pike
date well completed firm name county well located

| LANDOWNER: | description of formations encountered | from | to |
|--|---------------------------------------|------------|------------|
| <u>James Hayes</u> <u>P.O. 2, McComb, MS.</u> (mailing address) | | | |
| | <u>Red Sand</u> | <u>20</u> | <u>120</u> |
| | <u>White Chalk</u> | <u>120</u> | <u>160</u> |
| | <u>Coarse Sand & Gravel</u> | <u>160</u> | <u>172</u> |
| WELL LOCATION: | | | |
| sec. <u>9</u> T. <u>2</u> N. R. <u>9</u> E. S. W. | | | |
| <u>2</u> miles <u>S</u> of <u>Barto</u> (distance) (direction) (nearest town) | | | |
| WELL PURPOSE: <u>Home</u> (home, irrigation, municipal, industrial) | | | |
| WELL COMPLETION DATA: | | | |
| (1) diameter (inches) <u>4</u> | | | |
| (2) total depth (feet) <u>172</u> | | | |
| (3) static water level (feet) <u>120</u> below top of ground. | | | |
| (4) casing <u>PVC</u> , <u>162</u> (material) (depth) | | | |
| <u>4</u> (size) if telescope see back. | | | |
| (5) screen <u>80</u> , <u>162</u> (length) (depth to top) | | | |
| <u>4</u> , <u>PVC</u> (size) (material) | | | |
| (6) pump <u>1/2</u> , <u>10</u> (HP) (yield gpm) | | | |
| <u>Electric</u> (type power) | | | |
| (7) electric log <u>No</u> (yes or no) | | | |
| <u>Sanford</u> (organization running log) | | | |
| (8) how well bottom plugged <u>Sanford</u> | | | |


RECEIVED
JAN 30 1986

DRILLERS REMARKS:

Department of Natural Resources
Bureau of Land & Water Resources

If well telescopes please
sketch and show depths.

GROUND LEVEL

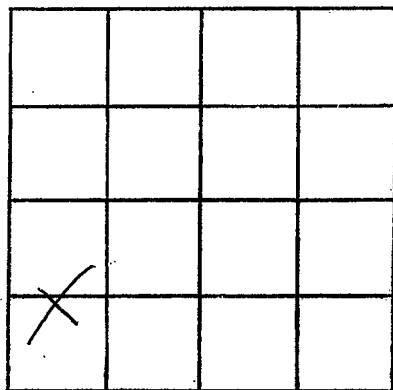

SECTION 9

Please indicate well location X.

ADDITIONAL INFORMATION

If more than one screen,
show locations of each on sketch.