

PIKE
J 2081

MISSISSIPPI DEPARTMENT OF NATURAL RESOURCES
Bureau of Land and Water Resources
Southport Mall
P.O. Box 10631
Jackson, Mississippi 39209
WATER WELL DRILLERS LOG

8-11 1987 *Fitzgerald Well Serv* Pike
date well completed firm name county well located

LANDOWNER:
Anthony Manzella
R.R. 2, McComb, MS
(mailing address)

description of formations encountered	from	to
<i>Red clay</i>	<i>0</i>	<i>20</i>
<i>Red sand</i>	<i>20</i>	<i>90</i>
<i>Fine sand</i>	<i>90</i>	<i>120</i>
<i>Coarse sand & gravel</i>	<i>120</i>	<i>134</i>

WELL LOCATION:
sec. 16 T 2 N R 9 E
9 miles E of McComb
(distance) (direction) (nearest town)

WELL PURPOSE: Home
(home, irrigation, municipal, industrial)

- WELL COMPLETION DATA:
- (1) diameter (inches) 4
 - (2) total depth (feet) 134
 - (3) static water level (feet) 95 below
top of ground.
 - (4) casing MC 124
(material) (depth)
4 if telescope see back.
(size)
 - (5) screen 10 124
(length) (depth to top)
4 MC
(size) (material)
 - (6) pump 1/2 10
(HP) (yield gpm)
elec
(type power)
 - (7) electric log no
(yes or no)
(organization running log)
 - (8) how well bottom plugged Sand Shik


RECEIVED
AUG 27 1987

Department of Natural Resources
Bureau of Land & Water Resources

DRILLERS REMARKS:

If well telescopes please sketch and show depths.

GROUND LEVEL

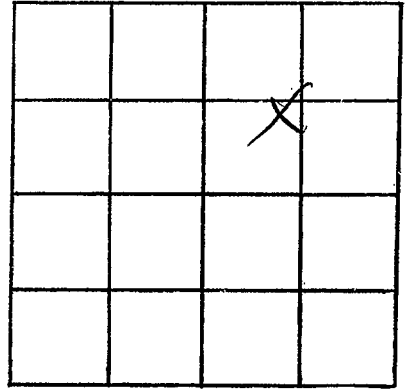

SECTION 16

Please indicate well location X.

ADDITIONAL INFORMATION

If more than one screen,
show locations of each on sketch.