

MISSISSIPPI DEPARTMENT OF NATURAL RESOURCES

Bureau of Land and Water Resources

Southport Mall

P.O. Box 10631

Jackson, Mississippi 39209

WATER WELL DRILLERS LOG

PIKE
5
2082

5-12 1987  
date well completed

Flanagan Well Co  
firm name


Pike  
county well located

LANDOWNER:	description of formations encountered	from	to
Broad Hansen P.B. McComb, Jr. (mailing address)			
WELL LOCATION:			
sec. <u>20</u> T. <u>2</u> N R. <u>9</u> E S W			
<u>11</u> miles <u>ESE</u> of <u>McComb</u> (distance) (direction) (nearest town)			
WELL PURPOSE: <u>Home</u> (home, irrigation, municipal, industrial)			
WELL COMPLETION DATA:			
(1) diameter (inches) <u>4</u>			
(2) total depth (feet) <u>150</u>			
(3) static water level (feet) <u>65</u> below top of ground.			
(4) casing <u>PVC</u> , <u>140</u> , (material) (depth) <u>4</u> (size) if telescope see back.			
(5) screen <u>10</u> , <u>140</u> (length) (depth to top) <u>4</u> , <u>PVC</u> (size) (material)			
(6) pump <u>1/2</u> , <u>10</u> (HP) (yield gpm) <u>elec</u> (type power)			
(7) electric log <u>No</u> (yes or no)			
(organization running log)			
(8) how well bottom plugged <u>Sand blk</u>			
DRILLERS REMARKS:			

**RECEIVED**  
 JUN 15 1987  
 Department of Natural Resources  
 Bureau of Land & Water Resources

If well telescopes please sketch and show depths.

GROUND LEVEL

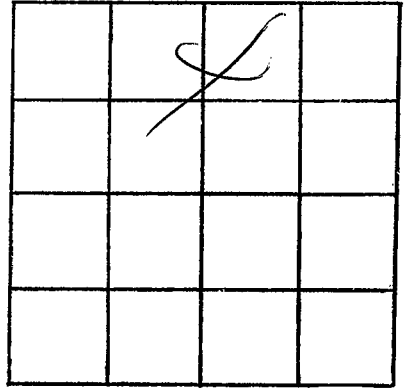

SECTION 20

Please indicate well location X.

ADDITIONAL INFORMATION

If more than one screen,  
show locations of each on sketch.