

# MISSISSIPPI DEPARTMENT OF NATURAL RESOURCES

Bureau of Land and Water Resources

P.O. Box 10631  
Jackson, Mississippi 39209  
WATER WELL DRILLERS LOG

COUNTY WELL LOCATED <i>Pike</i>	
WELL NUMBER <i>5</i>	CODED
DATE WELL COMPLETED <i>2084</i> <i>Nov 29 88</i>	

PERMIT NUMBER
NAME OF DRILLING FIRM <i>FITZGERALD Well Sew</i>

NAME & MAILING ADDRESS OF LANDOWNER <i>A. Johns</i> <i>R.R. 3 Ayltown ms.</i>			
WELL LOCATION:    SEC    TOWNSHIP    RANGE			
<i>6</i>		<i>2</i>	
<i>N</i>		<i>E</i>	
<i>S</i>		<i>W</i>	
DISTANCE <i>9</i> Miles		DIRECTION <i>N 15° E</i>	
		NEAREST TOWN <i>Waltham</i>	
OTHER LANDMARK			
WELL PURPOSE: Home, Irrigation, Municipal, Industrial, Fish Pond, etc. <i>Home</i>			

PUMP DATA		
PUMP TYPE (Circle One): <input checked="" type="radio"/> Submersible, <input type="radio"/> Turbine, <input type="radio"/> Jet <input type="radio"/> Flowing Well, <input type="radio"/> Other (Describe)		
POWER TYPE (Circle One): <input checked="" type="radio"/> Electric, <input type="radio"/> Tractor, <input type="radio"/> Diesel, <input type="radio"/> Gasoline, <input type="radio"/> Butane, <input type="radio"/> Other (Describe)		
Pump Capacity (GPM) <i>10</i>	No. of Stages <i>9</i>	Setting Depth <i>170</i> FT.
PUMP TEST		
Well yielded <i>10</i> GPM with a drawdown of <i>2</i> ft. after <i>1</i> hours of pumping		

WELL DATA		
Well Depth <i>132</i>	Casing Diameter (In.) <i>4</i>	Casing Length (Ft.) <i>122</i>
Type of Casing <i>PVC</i>	Hole Depth <i>132</i>	Depth to Static Water Level <i>96</i>
TYPE OF COMPLETION: (Circle One or More): <input checked="" type="checkbox"/> Gravel Packed, <input type="checkbox"/> Underreamed, <input type="checkbox"/> Telescoped, <input type="checkbox"/> Natural Development, <input type="checkbox"/> Open Hole, <input type="checkbox"/> Other (Describe)		
Top of Lap Pipe or Reduction in Casing <b>FEET</b> IF TELESCOPED OR MORE THAN ONE SCREEN: USE BACK PAGE		

LOG DATA	
TYPE OF LOG RUN (Circle One): <input type="radio"/> Electric, <input type="radio"/> Gamma Ray, <input type="radio"/> Density, <input type="radio"/> Sonic, <input checked="" type="radio"/> No Log Run, <input type="radio"/> Neutron, <input type="radio"/> Other (Describe)	
Name of Organization Running Log	

SCREEN DATA		
Diameter - Inches <i>4</i>	Length - Feet <i>10</i>	Slot Size - Inches <i>.014</i>
Screen Type <i>PVC</i>		Depth to Bottom - Feet <i>132</i>

GEOLOGIC DATA (Office Use Only)			
Surface Elev.	Geologic Unit	Unit Thickness	Depth to Top
Subs. SWL	Date	Analysis	Aquifer Test
Driller's Remarks			

DESCRIPTION OF FORMATIONS ENCOUNTERED	FROM	TO	FORMATIONS (Continued)	
			FROM	TO
<i>Red Clay</i>	<i>0</i>	<i>20</i>		
<i>Red Sand</i>	<i>20</i>	<i>90</i>		
<i>Coarse sand &amp; gravel</i>	<i>90</i>	<i>132</i>		

RECEIVED


JAN 03 1989

Department of Natural Resources  
Bureau of Land & Water Resources

IF MORE SPACE IS NEEDED, USE BACK.

If well telescopes please  
sketch and show depths.

GROUND LEVEL

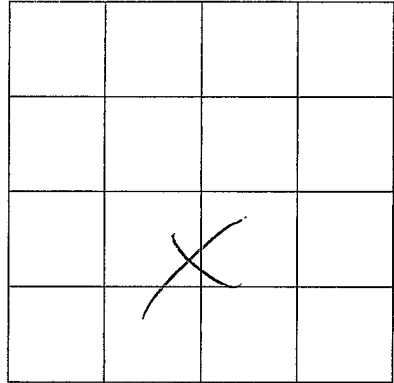

SECTION 6

Please indicate well location X.

ADDITIONAL INFORMATION

If more than one screen,  
show location of each on sketch.