

MISSISSIPPI DEPARTMENT OF NATURAL RESOURCES

Bureau of Land and Water Resources

COUNTY WELL LOCATED <i>Pike</i>	
WELL NUMBER <i>2</i>	CODED
DATE WELL COMPLETED <i>2086</i> <i>7-29-88</i>	

PERMIT NUMBER
NAME OF DRILLING FIRM <i>FITZGERALD Well Serv</i>

P.O. Box 10631
Jackson, Mississippi 39209
WATER WELL DRILLERS LOG

NAME & MAILING ADDRESS OF LANDOWNER <i>Pennis Connally</i> <i>RR. 2, McComb, ms.</i>			
WELL LOCATION:	SEC <i>4</i>	TOWNSHIP <i>2 N</i>	RANGE <i>9 E</i>
DISTANCE	DIRECTION	NEAREST TOWN	
<i>1.2</i> Miles	<i>S</i>	<i>Butte</i>	
OTHER LANDMARK			
WELL PURPOSE: Home, Irrigation, Municipal, Industrial, Fish Pond, etc. <i>Home</i>			

PUMP DATA		
PUMP TYPE (Circle One): <input checked="" type="radio"/> Submersible, <input type="radio"/> Turbine, <input type="radio"/> Jet <input type="radio"/> Flowing Well, Other (Describe) _____		
POWER TYPE (Circle One): <input checked="" type="radio"/> Electric, <input type="radio"/> Tractor, <input type="radio"/> Diesel, <input type="radio"/> Gasoline, <input type="radio"/> Butane, Other (Describe) _____		
Pump Capacity (GPM) <i>15</i>	No. of Stages <i>15</i>	Setting Depth <i>130</i> FT.
PUMP TEST		
Well yielded <i>15</i> GPM with a drawdown of <i>3</i> ft. after <i>2</i> hours of pumping		

WELL DATA		
Well Depth <i>185</i>	Casing Diameter (In.) <i>4</i>	Casing Length (Ft.) <i>175</i>
Type of Casing <i>PVC</i>	Hole Depth <i>185</i>	Depth to Static Water Level <i>100</i>
TYPE OF COMPLETION: (Circle One or More): <input checked="" type="checkbox"/> Gravel Packed, <input type="checkbox"/> Underreamed, <input type="checkbox"/> Telescoped, <input type="checkbox"/> Natural Development, <input type="checkbox"/> Open Hole, <input type="checkbox"/> Other (Describe) _____		
Top of Lap Pipe or Reduction in Casing FEET <input type="checkbox"/> IF TELESCOPED OR MORE THAN ONE SCREEN: USE BACK PAGE		


LOG DATA	
TYPE OF LOG RUN (Circle One): <input checked="" type="radio"/> No Log Run, <input type="radio"/> Electric, <input type="radio"/> Gamma Ray, <input type="radio"/> Density, <input type="radio"/> Sonic, <input type="radio"/> Neutron, Other (Describe) _____	
Name of Organization Running Log	

SCREEN DATA		
Diameter - Inches <i>4</i>	Length - Feet <i>10</i>	Slot Size - Inches <i>10/14</i>
Screen Type <i>PVC</i>	Depth to Bottom - Feet <i>185</i>	

GEOLOGIC DATA (Office Use Only)			
Surface Elev.	Geologic Unit	Unit Thickness	Depth to Top
Subs. SWL	Date	Analysis	Aquifer Test


Driller's Remarks

DESCRIPTION OF FORMATIONS ENCOUNTERED	FROM	TO
<i>Red Clay</i>	<i>0</i>	<i>20</i>
<i>Red Sand</i>	<i>20</i>	<i>60</i>
<i>Common white chalk</i>	<i>60</i>	<i>156</i>
<i>Common sandstone</i>	<i>156</i>	<i>185</i>

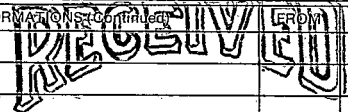 SEP 13 1988 Department of Natural Resources Bureau of Land & Water Resources
IF MORE SPACE IS NEEDED, USE BACK

If well telescopes please sketch and show depths.

GROUND LEVEL

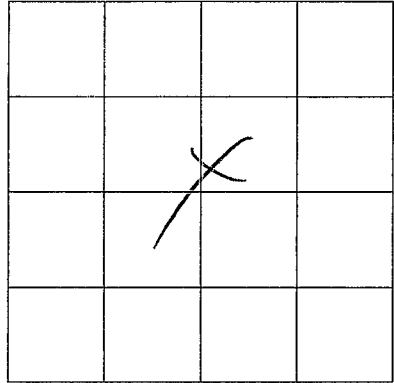

SECTION 4

Please indicate well location X.

ADDITIONAL INFORMATION

If more than one screen,
show location of each on sketch.