

MISSISSIPPI DEPARTMENT OF NATURAL RESOURCES

Bureau of Land and Water Resources

P.O. Box 10631
Jackson, Mississippi 39209
WATER WELL DRILLERS LOG

COUNTY WELL LOCATED
Pike

WELL NUMBER
1

PERMIT NUMBER
2091

DATE WELL COMPLETED
Aug 23-89

CODED

NAME OF DRILLING FIRM
F. FABER AND well Serv.

NAME & MAILING ADDRESS OF LANDOWNER
*3-01 Enterprises
RR - Tylertown ms.*

WELL LOCATION: SEC _____ TOWNSHIP _____ RANGE _____
2 2 N 9 E

DISTANCE _____ DIRECTION _____ NEAREST TOWN _____
1/2 Miles E of Bogalusa, LA River on 98 Hwy

OTHER LANDMARK _____

WELL PURPOSE: Home, Irrigation, Municipal, Industrial, Fish Pond, etc.
SAW Mill

PUMP DATA

PUMP TYPE (Circle One):
 Submersible, Turbine, Jet Flowing Well,
Other (Describe) _____

POWER TYPE (Circle One):
 Electric, Tractor, Diesel, Gasoline, Butane,
Other (Describe) _____ H/P _____

Pump Capacity (GPM)	No. of Stages	Setting Depth
<i>20</i>	<i>10</i>	<i>65</i> FT.

PUMP TEST

Well yielded *40* GPM with
a drawdown of *3* ft.
after *2* hours of pumping

WELL DATA

Well Depth	Casing Diameter (In.)	Casing Length (Ft.)
<i>100</i>	<i>4</i>	<i>90</i>

Type of Casing	Hole Depth	Depth to Static Water Level
<i>PVC</i>	<i>100</i>	<i>12</i>

TYPE OF COMPLETION: (Circle One or More):
 Gravel Packed, Underreamed, Telescoped,
 Natural Development, Open Hole, Other
(Describe) _____

Top of Lap Pipe or Reduction in Casing _____

FEET IF TELESCOPED OR MORE THAN ONE SCREEN: USE BACK PAGE

LOG DATA

TYPE OF LOG RUN (Circle One):
Electric, Gamma Ray, Density, Sonic, Neutron, Other (Describe) No Log Run

Name of Organization Running Log _____

SCREEN DATA

Diameter - Inches	Length - Feet	Slot Size - Inches
<i>4</i>	<i>10</i>	<i>0014</i>

Screen Type	Depth to Bottom - Feet
<i>PVC</i>	<i>100</i>

GEOLOGIC DATA (Office Use Only)

Surface Elev.	Geologic Unit	Unit Thickness	Depth to Top
Subs. SWL	Date	Analysis	Aperture Test

Driller's Remarks

RECEIVED

SEP 12 1989


Department of Natural Resources
Bureau of Land & Water Resources

DESCRIPTION OF FORMATIONS ENCOUNTERED	FROM	TO	FORMATIONS (Continued)	FROM	TO
<i>Red clay</i>	<i>0</i>	<i>10</i>			
<i>Red sand & gravel</i>	<i>10</i>	<i>40</i>			
<i>White & blue silt</i>	<i>40</i>	<i>85</i>			
<i>Coarse sand & gravel</i>	<i>85</i>	<i>100</i>			

IF MORE SPACE IS NEEDED, USE BACK

If well telescopes please sketch and show depths.

GROUND LEVEL

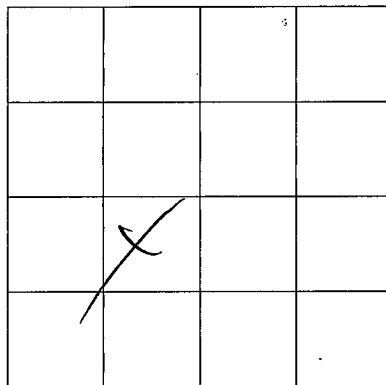

SECTION 2

Please indicate well location X.

ADDITIONAL INFORMATION

If more than one screen,
show location of each on sketch.