

MISSISSIPPI DEPARTMENT OF NATURAL RESOURCES

Bureau of Land and Water Resources

Southport Mall

P.O. Box 10631

Jackson, Mississippi 39209

WATER WELL DRILLERS LOG

MIKE  
J  
2097

10-4 date well completed 9-30 Fitzgibbon Well Serv firm name Polk county well located


LANDOWNER:  
James Sygona  
Rt. 2, W. Comb, ms.  
(mailing address)

description of formations encountered	from	to
<u>Red clay</u>	<u>0</u>	<u>20</u>
<u>Red sand</u>	<u>20</u>	<u>65</u>
<u>white clay</u>	<u>65</u>	<u>146</u>
<u>Coarse sand &amp; gravel</u>	<u>146</u>	<u>160</u>

WELL LOCATION:  
sec. 17 T. 2 N. R. 9 E  
S W  
4 miles S of Holmville  
(distance) (direction) (nearest town)

WELL PURPOSE:  
Home  
(home, irrigation, municipal, industrial)

- WELL COMPLETION DATA:
- (1) diameter (inches) 4
  - (2) total depth (feet) 160
  - (3) static water level (feet) 92 below above top of ground.
  - (4) casing WC 150,  
(material) (depth)  
4 If telescope see back.  
(size)
  - (5) screen 10, 150  
(length) (depth to top)  
4, WC  
(size) (material)
  - (6) pump 1/2, 10  
(HP) (yield gpm)  
elec  
(type power)
  - (7) electric log No  
(yes or no)  
So  
(organization running log)
  - (8) how well bottom plugged Sand plug

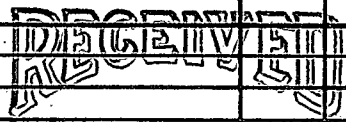


NOV 27 1990

Department of Natural Resources  
Bureau of Land & Water Resources

DRILLERS REMARKS:

If well telescopes please sketch and show depths.

GROUND LEVEL

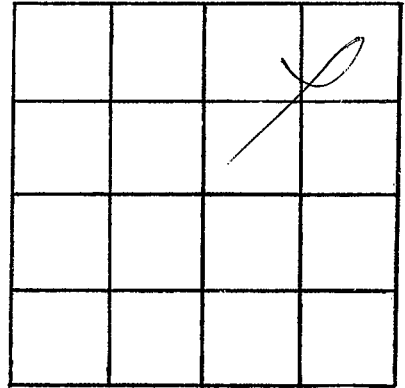

SECTION 12

Please indicate well location X.

ADDITIONAL INFORMATION

If more than one screen,  
show locations of each on sketch.