

**MISSISSIPPI DEPARTMENT OF ENVIRONMENTAL QUALITY**  
Bureau of Land and Water Resources

P. O. Box 10631  
Jackson, MS 39289-0631  
**WATER WELL DRILLERS LOG**

COUNTY WELL LOCATED <u>PIKE</u>	
WELL NUMBER <u>2</u>	CODED
DATE WELL COMPLETED <u>2098</u> <u>MARCH 28 91</u>	

PERMIT NUMBER
NAME OF DRILLING FIRM <u>FITZGERALD well serv</u>

NAME & MAILING ADDRESS OF LANDOWNER <u>MARK RICHARDSON</u> <u>P.O. McCombs, ms</u>			
WELL LOCATION: SEC	TOWNSHIP	RANGE	
<u>23</u>	<u>2</u>	<u>N</u>	<u>E</u>
		<u>S</u>	<u>9</u>
DISTANCE	DIRECTION	NEAREST TOWN	
<u>6</u> Miles	<u>SE</u>	<u>of Holmesville</u>	
OTHER LANDMARK			
WELL PURPOSE: Home, Irrigation, Municipal, Industrial, Fish Pond, etc. <u>Home</u>			

PUMP DATA		
PUMP TYPE (Circle One): <u>Submersible</u> , Turbine, Jet, Flowing Well, Other (Describe) _____		
POWER TYPE (Circle One): <u>Electric</u> , Tractor, Diesel, Gasoline, Butane, Other (Describe) _____		
Pump Capacity (GPM) <u>16</u>	No. of Stages <u>8</u>	Setting Depth <u>85</u> FT.
PUMP TEST		
Well yielded <u>15</u> GPM with a drawdown of <u>2</u> ft. after <u>2</u> hours of pumping		

WELL DATA		
Well Depth <u>160</u>	Casing Diameter (In.) <u>4</u>	Casing Length (Ft.) <u>150</u>
Type of Casing <u>NOC</u>	Hole Depth <u>160</u>	Depth to Static Water Level <u>50</u>
TYPE OF COMPLETION: (Circle One or More): <u>Gravel Packed</u> , Underreamed, Telescoped, Natural Development, Open Hole, Other		
Top of Lap Pipe or Reduction in Casing <u>FEET</u> IF TELESCOPED OR MORE THAN ONE SCREEN: USE BACK PAGE		

LOG DATA	
TYPE OF LOG RUN (Circle One): <u>No Log Run</u> , Electric, Gamma Ray, Density, Sonic, Neutron, Other (Describe) _____	
Name of Organization Running Log	

SCREEN DATA		
Diameter - Inches <u>4</u>	Length - Feet <u>10</u>	Slot Size - Inches <u>.014</u>
Screen Type <u>NOC</u>	Depth to Bottom - Feet <u>160</u>	

GEOLOGIC DATA (Office Use Only)			
Surface Elev.	Geologic Unit	Unit Thickness	Depth to Top
Subs. SWL	Date	Analysis	Aquifer Test
Driller's Remarks			


DESCRIPTION OF FORMATIONS ENCOUNTERED	FROM	TO	FORMATIONS (Continued) FROM	TO
<u>Red clay</u>	<u>0</u>	<u>15</u>		
<u>Red SAND</u>	<u>15</u>	<u>50</u>		
<u>white &amp; blue clay</u>	<u>50</u>	<u>144</u>		
<u>Coarse sand &amp; grit</u>	<u>144</u>	<u>160</u>		

**REGISTERED**  
**MAY 28 1991**  
Dept. of Environmental Quality  
Bureau of Land & Water Resources

IF MORE SPACE IS NEEDED, USE BACK

If well telescopes please sketch and show depths.

GROUND LEVEL

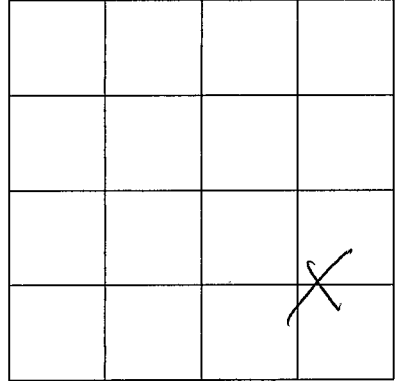

SECTION 23

Please indicate well location X.

ADDITIONAL INFORMATION

If more than one screen,  
show location of each on sketch.