

MISSISSIPPI DEPARTMENT OF ENVIRONMENTAL QUALITY
Bureau of Land and Water Resources

P. O. Box 10631
Jackson, MS 39289-0631
WATER WELL DRILLERS LOG

COUNTY WELL LOCATED Fike	
WELL NUMBER 5	CODED
DATE WELL COMPLETED 2105 7-10-92	

PERMIT NUMBER
NAME OF DRILLING FIRM Fitzgerald Waterwell

NAME & MAILING ADDRESS OF LANDOWNER Edna Downs R.R. McComb			
WELL LOCATION:	SEC 9	TOWNSHIP 2 N S	RANGE 9 E W
DISTANCE 1 Miles	DIRECTION N	NEAREST TOWN Loggatt	
OTHER LANDMARK			
WELL PURPOSE: <input checked="" type="radio"/> Home, Irrigation, Municipal, Industrial, Fish Pond, etc.			

PUMP DATA			
PUMP TYPE (Circle One): <input checked="" type="radio"/> Submersible, Turbine, Jet, Flowing Well, Other (Describe)			
POWER TYPE (Circle One): <input checked="" type="radio"/> Electric, Tractor, Diesel, Gasoline, Butane, Other (Describe) H/P			
Pump Capacity (GPM) 10	No. of Stages 9	Setting Depth 140 FT.	
PUMP TEST			
Well yielded 25 GPM with a drawdown of 3 ft. after 2 hours of pumping			

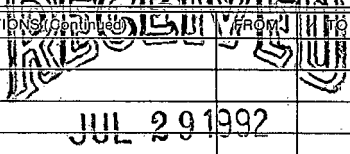
WELL DATA		
Well Depth 165	Casing Diameter (In.) 4	Casing Length (Ft.) 155
Type of Casing PVC	Hole Depth 165	Depth to Static Water Level 114
TYPE OF COMPLETION: (Circle One or More): <input checked="" type="radio"/> Gravel Packed, Underreamed, Telescoped, Natural Development, Open Hole, Other (Describe)		
Top of Lap Pipe or Reduction in Casing FEET <input type="checkbox"/> IF TELESCOPED OR MORE THAN ONE SCREEN: USE BACK PAGE		

LOG DATA	
TYPE OF LOG RUN (Circle One): Electric, Gamma Ray, Density, Sonic, <input checked="" type="radio"/> No Log Run, Neutron, Other (Describe)	
Name of Organization Running Log	

SCREEN DATA		
Diameter - Inches 4	Length - Feet 10	Slot Size - Inches .014
Screen Type PVC		Depth to Bottom - Feet 165

GEOLOGIC DATA (Office Use Only)			
Surface Elev.	Geologic Unit	Unit Thickness	Depth to Top
Subs. SWL	Date	Analysis	Aquifer Test
Driller's Remarks			

DESCRIPTION OF FORMATIONS ENCOUNTERED	FROM	TO
Red sand + gravel	0	80
Red clay	80	120
Red sand	120	140
Red sand + gravel	140	150
Coarse sand + gravel	150	165

	
Dept. of Environmental Quality Bureau of Land & Water Resources	
IF MORE SPACE IS NEEDED, USE BACK	

If well telescopes please
sketch and show depths.

GROUND LEVEL

SECTION _____

Please indicate well location X.

ADDITIONAL INFORMATION

If more than one screen,
show location of each on sketch.