

MISSISSIPPI DEPARTMENT OF ENVIRONMENTAL QUALITY

Office of Land and Water Resources

P. O. Box 10631
Jackson, MS 39289-0631
WATER WELL DRILLERS LOG

COUNTY WELL LOCATED
Pike

WELL NUMBER 2107 CODED

DATE WELL COMPLETED
October 7-92

PERMIT NUMBER

NAME OF DRILLING FIRM
F. PAGER AND WELL SERV

NAME & MAILING ADDRESS OF LANDOWNER
MASO4 JACKSON - RR-2 McComb MS

WELL LOCATION: SEC 22 TOWNSHIP 2 RANGE 9
S N E
W

DISTANCE 9 Miles DIRECTION E NEAREST TOWN of McComb

OTHER LANDMARK

WELL PURPOSE: Home, Irrigation, Municipal, Industrial, Fish Pond, etc.
Home

PUMP DATA

PUMP TYPE (Circle One):
Submersible, Turbine, Jet, Flowing Well,
Other (Describe)

POWER TYPE (Circle One):
Electric, Tractor, Diesel, Gasoline, Butane,
Other (Describe) H/P

Pump Capacity (GPM) 10 No. of Stages 8 Setting Depth 95 FT.

PUMP TEST
Well yielded 20 GPM with
a drawdown of 3 ft.
after 2 hours of pumping

WELL DATA

Well Depth 100 Casing Diameter (In.) 4 Casing Length (Ft.) 90

Type of Casing PVC Hole Depth 100 Depth to Static Water Level 76

TYPE OF COMPLETION: (Circle One or More):
Gravel Packed, Underreamed, Telescoped,
Natural Development, Open Hole, Other
(Describe)

LOG DATA

TYPE OF LOG RUN (Circle One):
Electric, Gamma Ray, Density, Sonic, Neutron,
Other (Describe) No Log Run

Name of Organization Running Log

WELL GROUTED TO A DEPTH OF 10 FEET
Type Grout (circle one): Cement, Bentonite, or Mix

GEOLOGIC DATA (Office Use Only)

Surface Elev.	Geologic Unit	Unit Thickness	Depth to Top
Subs. SWL	Date	Analysis	Aquifer Test

SCREEN DATA

Diameter - Inches <u>4</u>	Length - Feet <u>10</u>	Slot Size - Inches <u>.014</u>
Screen Type <u>PVC</u>	Depth to Bottom - Feet <u>100</u>	


Driller's Remarks

DESCRIPTION OF FORMATIONS ENCOUNTERED	FROM	TO	FORMATIONS (Continued)	FROM	TO
<u>Red Clay</u>	<u>0</u>	<u>20</u>	RECEIVED DEC 07 1992 Dept. of Environmental Quality Bureau of Land & Water Resources		
<u>Red sand</u>	<u>20</u>	<u>80</u>			
<u>Coarse sand & gravel</u>	<u>80</u>	<u>100</u>			

IF MORE SPACE IS NEEDED, USE BACK

If well telescopes please sketch and show depths.

GROUND LEVEL

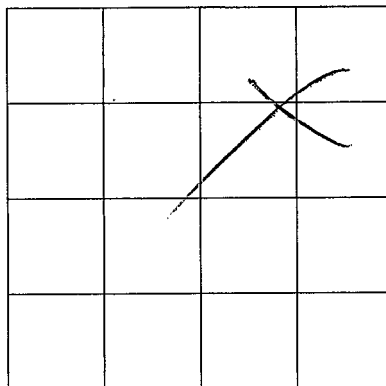

SECTION 22

Please indicate well location X.

ADDITIONAL INFORMATION

If more than one screen,
show location of each on sketch.