

MISSISSIPPI DEPARTMENT OF ENVIRONMENTAL QUALITY

Office of Land and Water Resources

P. O. Box 10631
Jackson, MS 39289-0631
WATER WELL DRILLERS LOG

COUNTY WELL LOCATED <u>Pike</u>	
WELL NUMBER <u>J 2117</u>	CODED
DATE WELL COMPLETED <u>11-9-95</u>	

PERMIT NUMBER
NAME OF DRILLING FIRM <u>Fitzgerald Well Services</u>

NAME & MAILING ADDRESS OF LANDOWNER <u>Wayne Myers</u> <u>RR McComb</u>			
WELL LOCATION:	SEC <u>9</u>	TOWNSHIP <u>2</u>	RANGE <u>N 9 E</u>
DISTANCE <u>8</u> Miles	DIRECTION <u>ESE</u>	NEAREST TOWN <u>McComb</u>	
OTHER LANDMARK			
WELL PURPOSE <input checked="" type="checkbox"/> Home, Irrigation, Municipal, Industrial, Fish Pond, etc.			

PUMP DATA			
PUMP TYPE (Circle One): <input checked="" type="radio"/> Submersible, Turbine, Jet Flowing Well, Other (Describe) _____			
POWER TYPE (Circle One): <input checked="" type="radio"/> Electric, Tractor, Diesel, Gasoline, Butane, Other (Describe) _____ H/P <u>1</u>			
Pump Capacity (GPM) <u>20</u>	No. of Stages <u>10</u>	Setting Depth <u>130</u>	FT.
PUMP TEST			
Well yielded <u>20</u> GPM with a drawdown of <u>1</u> ft. after <u>1</u> hours of pumping			

WELL DATA		
Well Depth <u>180</u>	Casing Diameter (In.) <u>4"</u>	Casing Length (Ft.) <u>160'</u>
Type of Casing <u>PVC</u>	Hole Depth <u>180'</u>	Depth to Static Water Level <u>81'</u>

LOG DATA	
TYPE OF LOG RUN (Circle One): Electric, Gamma Ray, Density, Sonic, Neutron, Other (Describe) _____	
Name of Organization Running Log	

TYPE OF COMPLETION: (Circle One or More):
 Gravel Packed, Underreamed, Telescoped,
Natural Development, Open Hole, Other

GEOLOGIC DATA (Office Use Only)			
Surface Elev.	Geologic Unit	Unit Thickness	Depth to Top
Subs. SWL	Date	Analysis	Aquifer Test

WELL GROUTED TO A DEPTH OF 10 FEET
Type Grout (circle one): Cement, Bentonite, Mix

Driller's Remarks			
Top of Lap Pipe or Reduction in Casing			
FEET		IF TELESCOPED OR MORE THAN ONE SCREEN: USE BACK PAGE	


SCREEN DATA		
Diameter - Inches <u>4"</u>	Length - Feet <u>20</u>	Slot Size - Inches <u>0.2/0.10</u>
Screen Type <u>PVC</u>	Depth to Bottom - Feet <u>180'</u>	

DESCRIPTION OF FORMATIONS ENCOUNTERED	FROM	TO
Top soil	0	5
Sand & gravel	5	80
white clay	80	120
Fine sand	100	160
course sand	100	180

FORMATIONS (continued)	FROM	TO
DRILLER'S SIGNATURE		
FEB 06 1996		
Dept. of Environmental Quality Office of Land & Water Resources		

If well telescopes please sketch and show depths.

GROUND LEVEL

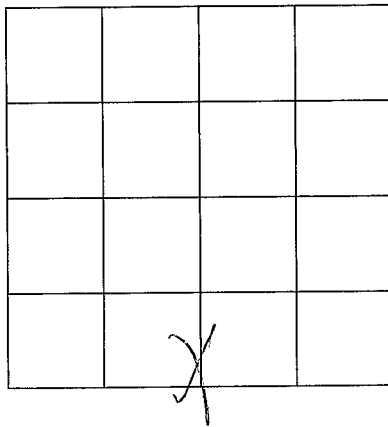

SECTION _____

Please indicate well location X.

ADDITIONAL INFORMATION

If more than one screen,
show location of each on sketch.