

MISSISSIPPI DEPARTMENT OF ENVIRONMENTAL QUALITY

Office of Land and Water Resources

P. O. Box 10631
Jackson, MS 39289-0631
WATER WELL DRILLERS LOG

COUNTY WELL LOCATED <i>Dike</i>	
WELL NUMBER <i>I 2118</i>	CODED
DATE WELL COMPLETED <i>7-30-96</i>	

PERMIT NUMBER
NAME OF DRILLING FIRM <i>Fitzgerald well service</i>

NAME & MAILING ADDRESS OF LANDOWNER <i>Randy Distorius</i> <i>RR Tylerdon</i>		
WELL LOCATION: SEC <i>2</i> TOWNSHIP <i>2</i> RANGE <i>N 9 E</i>		
DISTANCE <i>10</i> Miles <i>W</i> of <i>Tylerdon</i>		
OTHER LANDMARK		
WELL PURPOSE: <input checked="" type="radio"/> Home, Irrigation, Municipal, Industrial, Fish Pond, etc.		

PUMP DATA		
PUMP TYPE (Circle One): <input checked="" type="radio"/> Submersible, Turbine, Jet, Flowing Well, Other (Describe) _____		
POWER TYPE (Circle One): <input checked="" type="radio"/> Electric, Tractor, Diesel, Gasoline, Butane, Other (Describe) _____ H/P <i>1/2</i>		
Pump Capacity (GPM) <i>108</i>	No. of Stages <i>8</i>	Setting Depth <i>100</i> FT.
PUMP TEST		
Well yielded <i>50</i> GPM with a drawdown of <i>1</i> ft. after <i>1</i> hours of pumping		

WELL DATA		
Well Depth <i>150'</i>	Casing Diameter (In.) <i>4"</i>	Casing Length (Ft.) <i>140'</i>
Type of Casing <i>Pvc</i>	Hole Depth <i>150'</i>	Depth to Static Water Level <i>67'</i>
TYPE OF COMPLETION: (Circle One or More): <input checked="" type="radio"/> Gravel Packed, Underreamed, Telescoped, Natural Development, Open Hole, Other (Describe) _____		
WELL GROUTED TO A DEPTH OF <i>10</i> FEET Type Grout (circle one): Cement, Bentonite, <input checked="" type="radio"/> Mix		

LOG DATA	
TYPE OF LOG RUN (Circle One): Electric, Gamma Ray, Density, Sonic, <input checked="" type="radio"/> No Log Run, Other (Describe) _____	
Name of Organization Running Log	

SCREEN DATA		
Diameter - Inches <i>4"</i>	Length - Feet <i>10'</i>	Slot Size - Inches <i>012</i>
Screen Type <i>Pvc</i>	Depth to Bottom - Feet <i>150'</i>	

GEOLOGIC DATA (Office Use Only)			
Surface Elev.	Geologic Unit	Unit Thickness	Depth to Top
Subs. SWL	Date	Analysis	Aquifer Test
Driller's Remarks			
Top of Lap Pipe or Reduction in Casing			

DESCRIPTION OF FORMATIONS ENCOUNTERED	FROM	TO
<i>Top soil</i>	<i>0</i>	<i>5</i>
<i>red clay</i>	<i>5</i>	<i>30</i>
<i>sand & gravel</i>	<i>30</i>	<i>100</i>
<i>red clay</i>	<i>100</i>	<i>120</i>
<i>fine sand</i>	<i>120</i>	<i>140</i>
<i>course sand & gravel</i>	<i>140</i>	<i>150</i>

IF TELESCOPED OR MORE THAN ONE SCREEN USE BACK PAGE

FORMATIONS (continued) FROM TO

RECEIVED


DEC 02 1996

Dept. of Environmental Quality
Office of Land & Water Resources

IF MORE SPACE IS NEEDED, USE BACK

If well telescopes please sketch and show depths.

GROUND LEVEL

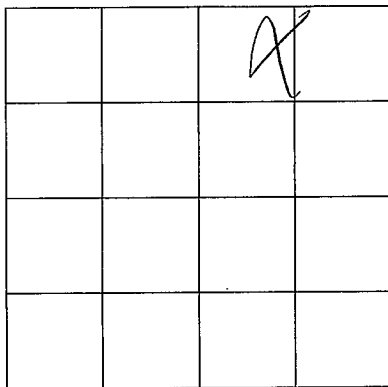

SECTION _____

Please indicate well location X.

ADDITIONAL INFORMATION

If more than one screen,
show location of each on sketch.