




If well telescopes please sketch and show depths.

GROUND LEVEL

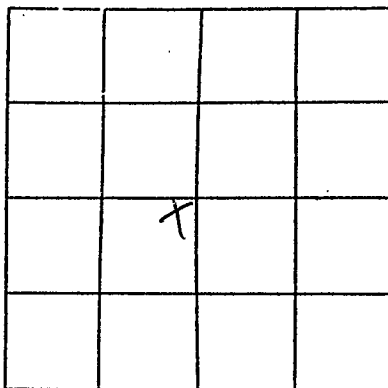

SECTION 33

Please indicate well location X.

Pump Capacity (GPM)	No. of Stages	Setting Depth
		130' FT.

PUMP TEST

Well yielded 100 GPM with  
 a drawdown of 0 ft.  
 after 1 hours of pumping

LOG DATA

TYPE OF LOG RUN (Circle One):  No Log Run,  Electric,  Gamma Ray,  Density,  Sonic,  Neutron,  Other (Describe) \_\_\_\_\_

Name of Organization Running Log \_\_\_\_\_

GEOLOGIC DATA (Office Use Only)

Surface Elev.	Geologic Unit	Unit Thickness	Depth to Top
Subs. SWL	Date	Analysis	Aquifer Test

Driller's Remarks

\_\_\_\_\_  
 \_\_\_\_\_  
If more than one screen, show location of each on sketch.