

Pike
K1
6-17-72

MISSISSIPPI
BOARD OF WATER COMMISSIONERS
416 North State Street
Jackson, Mississippi 39201

WATER WELL DRILLERS LOG

CODED

17 Jul 1972 SY P... K1 R
date well completed firm name county well located

LANDOWNER:	description of formations encountered	from	to
Pinto Stewart		0	25
Magnolia (mailing address)	Clay Red Clay	25	40
WELL LOCATION:	Sand	100	55
sec. 13 T 1 N R 7 E 7 miles S of MAR. (distance) (direction) (nearest town)	Sand Chalk	55	75
WELL PURPOSE: (home, irrigation, municipal, industrial)	Sand	75	140
WELL COMPLETION DATA:	Sand	140	155
(1) diameter (inches) 4		155	168
(2) total depth (feet) 168			
(3) static water level (feet) 95 below top of ground			
(4) casing PI 162 (material) (depth)			
(size) if telescope see back.			
(5) screen 6 162 (length) (depth to top)			
(size) PI (material)			
(6) pump 1/2 8 (HP) (yield gpm)			
(type power) Elect			
(7) electric log (yes or no)			
(organization running log)			
(8) how well bottom plugged Wash			
DRILLERS REMARKS:			


CODED

BRINE 1 R 10/12

MISSISSIPPI BOARD OF WATER COMMISSIONERS

If well telescopes please sketch and show depths.

GROUND LEVEL

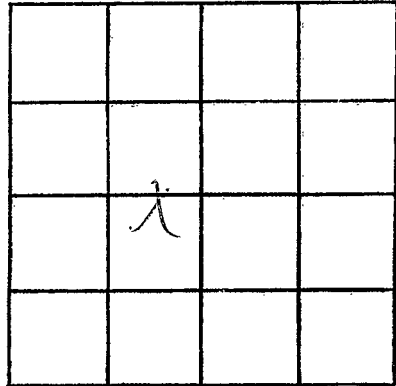

SECTION 13

Please indicate well location X.

ADDITIONAL INFORMATION

If more than one screen,
show locations of each on sketch.