

PIKE

K 9

4-13-62 CODED

WATER WELL DRILLERS LOG

Date: 4-13, 1962, Driller: Chester Reeves County PIKE

(Name)

(1) Owner of Land: Odie Brown  
 (Name)  
RFD, Magnolia  
 (Address)

(2) Location: 1/4, 1/4, Sec. 5 T1 R7  
4 miles north of Osyka  
 (distance) (direction) (Nearest Town)

(3) Topography: Hilly  
 (Hilly) (Flat) (Level)

(4) Purpose of Well: Domestic  
 (Domestic Irrigation  
 Municipal, Industrial, Other)

Description & Color of Materials Sand, Clay, Red Clay, Shell, etc.	Thick- ness Feet	Depth Feet
<u>Red clay</u>	<u>10</u>	<u>10</u>
<u>Brown gravel and sand</u>	<u>50</u>	<u>60</u>
<u>Sand sand and yellow chalk</u>	<u>55</u>	<u>115</u>
<u>Clean sand and pea gravel</u>	<u>7</u>	<u>122</u>

CODED

Information upon completion of well:

(1) Diameter 2 inches.


(2) Total Depth 122 feet.

(3) Water Level 62 feet below top of ground.

(4) Cased to Bottom Size 2"

(5) Screen: Size 1/4, Length 6'

(6) Were any formations sealed against pollution?  
 \_\_\_\_\_ yes, \_\_\_\_\_  no.

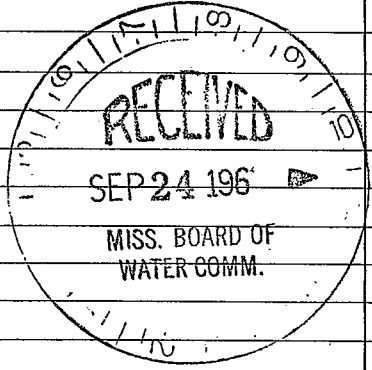

If YES depth of formation \_\_\_\_\_

Why \_\_\_\_\_

Drillers Remarks: \_\_\_\_\_

No previous well

REEVES WELL AND PUMP CO.  
 Phone 1250  
 McCOMB, MISSISSIPPI

(Use Back Side)

Well No.

1914

1915

1916

1917

1918