

K10 CODED

6-10-64

WATER WELL DRILLERS LOG

Date: 6-10, 1964, Driller: Charles Reeves County Pike
 (Name)

(1) Owner of Land: Miss Ruth Fulmer
 (Name)
RFD, Magnolia
 (Address)
 (2) Location: 1/4, 1/4, Sec. 1 T. 1 R. 7
2 miles N.E. of Chatawa
 (distance) (direction) (Nearest Town)
 (3) Topography: Hilly
 (Hilly) (Flat) (Level)
 (4) Purpose of Well: Domestic
 (Domestic Irrigation
 Municipal, Industrial, Other)


Description & Color of Materials Sand, Clay, Red Clay, Shell, etc.	Thick- ness Feet	Depth Feet
<u>Clay sand</u>	<u>20</u>	<u>20</u>
<u>Yellow sand</u>	<u>55</u>	<u>75</u>
<u>Red chalky</u>		
<u>Gravel</u>	<u>5</u>	<u>80</u>
<u>Blue shell</u>	<u>170</u>	<u>250</u>
<u>Coarse sand</u>	<u>45</u>	<u>295</u>

Information upon completion of well:

(1) Diameter 4 inches.
 (2) Total Depth 295 feet.
 (3) Water Level 27 feet below top of ground.
 (4) Cased to Bottom, Size 4"
 (5) Screen: Size 4", Length 9'
 (6) Were any formations sealed against pollution?
 _____ yes, no.

If YES depth of formation _____
 Why _____
 Drillers Remarks: old well
bad

CODED

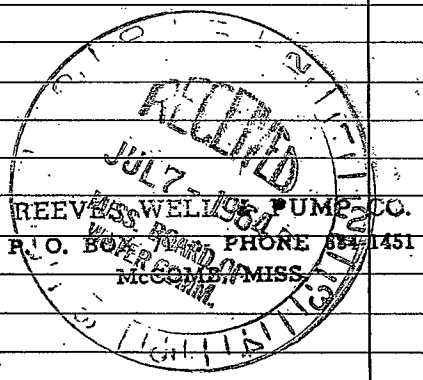

(Use Back Side)

Well No.

1870

1871

1872

1873

1874

1875

1876

1877

1878