

PIKE MISSISSIPPI BOARD OF WATER COMMISSIONERS

K12 CODED

11-13-65

WATER WELL DRILLERS LOG

Date: 11-13, 1965, Driller: J. T. Covington Son County Pike
 (Name)

(1) Owner of Land: Fred Hardin
 (Name)
Chatawa, Miss.
 (Address)

(2) Location: 1/4, 1/4, Sec. 10 T1R7,
6 miles S of Magnolia,
 (distance) (direction) (Nearest Town)

(3) Topography: Hilly
 (Hilly) (Flat) (Level)

(4) Purpose of Well: Domestic
 (Domestic Irrigation
 Municipal, Industrial, Other)

Description & Color of Materials Sand, Clay, Red Clay, Shell, etc.	Thick- ness Feet	Depth Feet
<u>Sandy Clay</u>	<u>20</u>	<u>20</u>
<u>Rocky gravel</u>	<u>50</u>	<u>70</u>
<u>Sand</u>	<u>18</u>	<u>88</u>

Information upon completion of well:

(1) Diameter 4" inches.

(2) Total Depth 88' feet.


(3) Water Level 60' feet below top of ground.

(4) Cased to 88', Size 4"

(5) Screen: Size 4", Length 6'

(6) Were any formations sealed against pollution?
no yes, no.

CODED

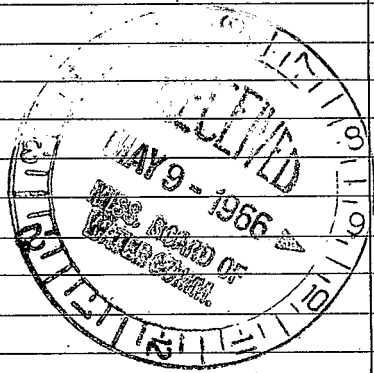

If YES depth of formation _____

Why _____

Drillers Remarks: _____

(Use Back Side)

Well No.

[The page contains extremely faint and illegible text, likely bleed-through from the reverse side of the document. No specific words or phrases can be discerned.]