

PIKE
K18

MISSISSIPPI BOARD OF WATER COMMISSIONERS

10-9-63 CODED

WATER WELL DRILLERS LOG

CODED

Date: 10-9-63, Driller: Chester Reeves County: Pike
(Name)

(1) Owner of Land: John Speed
(Name)

RFD, Osyka
(Address)

(2) Location: 1/4, 1/4, Sec. 15, T. 1 R. 7

1 miles S.W. Chatawa
(distance) (direction) (Nearest Town)

(3) Topography: Hilly
(Hilly) (Flat) (Level)

(4) Purpose of Well: Domestic
(Domestic Irrigation
Municipal, Industrial, Other)

Description & Color of Materials Sand, Clay, Red Clay, Shell, etc.	Thick- ness Feet
Red Clay	25-25
Red Sand	25-50
Gravel	5-55
Coarse yellow sand	30-85

Information upon completion of well:

(1) Diameter 4 inches.

(2) Total Depth 85 feet.

(3) Water Level 60 feet below top of ground.

(4) Cased to Bottom size 4


(5) Screen: Size 4", Length 5'

(6) Were any formations sealed against pollution?
yes, no.

If YES depth of formation

Why

Drillers, Remarks: New well for Dairy Barn

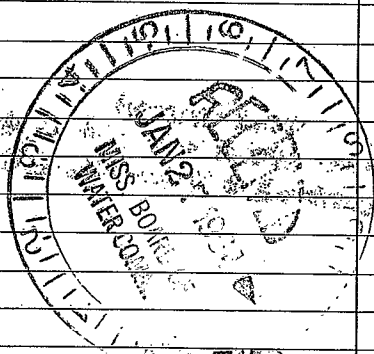

CODED

REEVES WELL & PUMP CO.
P. O. BOX 71 - PHONE 684-1451
McCOMB, MISS.

(Use Back Side)

Well No.

1870

...

...

