

Pike CODED
 K19
 5-68

MISSISSIPPI
 BOARD OF WATER COMMISSIONERS
 416 North State Street
 Jackson, Mississippi 39201

WATER WELL DRILLERS LOG

May 11 1968 Keenum Well Pump Pike
 date well completed firm name county well located

LANDOWNER: E. K. Jacobson
RFD #1
Oxyha
 (mailing address)

WELL LOCATION:
 sec 28 T N R 7 E
2 1/2 miles NW of Oxyha
 (distance) (direction) (nearest town)


WELL PURPOSE: Home
 (home, irrigation, municipal, industrial)

WELL COMPLETION DATA:

- (1) diameter (inches) 4"
- (2) total depth (feet) 158 ft.
- (3) static water level (feet) 30 below top of ground.
- (4) casing Plastic pvc
 (material) (depth)
- (size) If telescope see back.
- (5) screen 6' 157'
 (length) (depth to top)
4" Plastic
 (size) (material)
- (6) pump 3/4 HP 15
 (HP) (yield gpm)
Elect
 (type power)
- (7) electric log No
 (yes or no)
- (organization running log)
- (8) how well bottom plugged
wasn't plugged

Description of formations encountered	from	to
red clay	0	12
sand & gravel	12	25
gravel	25	40
white chalk	40	102
fine white sand	102	138
coarse white sand	138	158


CODED

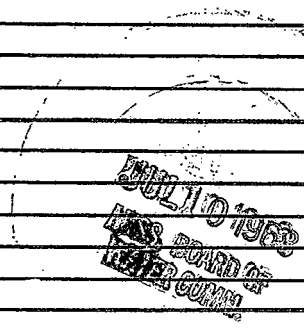

DRILLERS REMARKS:
old 2" aged
well

If well telescopes please sketch and show depths.

GROUND LEVEL

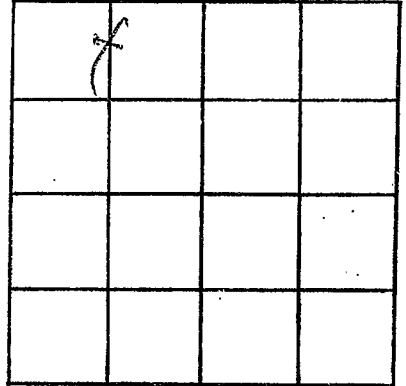

SECTION 28

Please indicate well location X.

ADDITIONAL INFORMATION

If more than one screen, show locations of each on sketch.

5