

CODED

Pike
K 20
7-68

MISSISSIPPI
BOARD OF WATER COMMISSIONERS
416 North State Street
Jackson, Mississippi 39201

WATER WELL DRILLERS LOG

7-25 1968 18 Fitzgerald Water Well Pike
date well completed firm name county well located

LANDOWNER: Otto Welch
Margaret R. Miss
(mailing address)

description of formations encountered	from	to
top soil & clay	0	15
sand	15	65
sand & gravel	65	85
sand	85	95
Red chert	95	102
gravel & sand	102	120

WELL LOCATION:
sec. 16 T 1 N R 6 E
15 miles SW of Magnolia
(distance) (direction) (nearest town)


WELL PURPOSE:
(home, irrigation, municipal, industrial)

WELL COMPLETION DATA:
(1) diameter (inches) 4
(2) total depth (feet) 120
(3) static water level (feet) 90 below above top of ground.
(4) casing plastic 1 1/4
(material) (depth)
4 if telescope see back.
(size)
(5) screen 6' 1 1/4
(length) (depth to top)
4 Sch 40
(size) (material)
(6) pump _____ (HP) _____ (yield gpm)
(type power)

(7) electric log NO
(yes or no)
(organization running log)
(8) how well bottom plugged Wood peg


DRILLERS REMARKS:

CODED

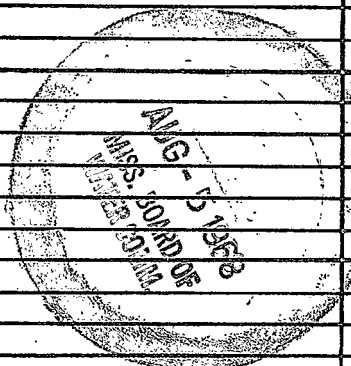

If well telescopes please sketch and show depths.

GROUND LEVEL

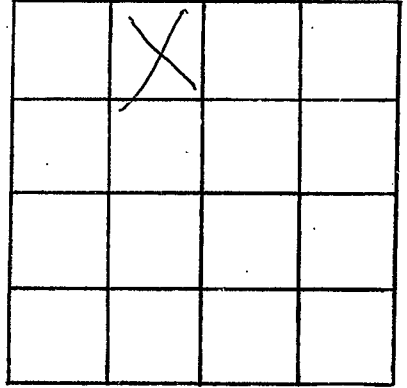

SECTION 16

Please indicate well location X.

ADDITIONAL INFORMATION

If more than one screen,
show locations of each on sketch.