

Pike
K 21
7-68

MISSISSIPPI
BOARD OF WATER COMMISSIONERS
416 North State Street
Jackson, Mississippi 39201

WATER WELL DRILLERS LOG

July 31 1968 J. T. Covington Pike
date well completed firm name county well located

LANDOWNER: Clyde Roberts

description of formations encountered	from	to
CLAY SAND	0	15
	15	65

Magnolia Miss.
(mailing address)


WELL LOCATION:
sec. 7 T 1 N R. 7 E
9 NE S NE W
9 miles S.W. of Magnolia
(distance) (direction) (nearest town)

WELL PURPOSE: Home
(home, irrigation, municipal, industrial)

WELL COMPLETION DATA:

- (1) diameter (inches) 4"
- (2) total depth (feet) 65'
- (3) static water level (feet) 50' below top of ground.
- (4) casing Plastic, 59' (material) (depth)
- 4" (size) if telescope see back.
- (5) screen 6' 65' (length) (depth to top)
- 4" Plastic (size) (material)
- (6) pump 2 (HP) 6 (yield gpm)
- R.e. (type power)
- (7) electric log (yes or no)
- (organization running log)
- (8) how well bottom plugged lead

CODED

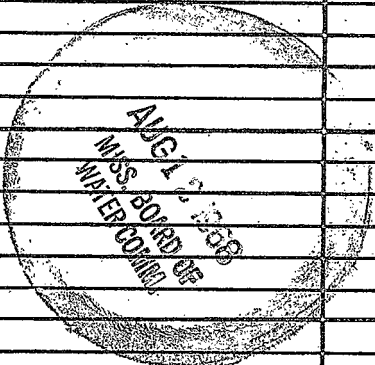

DRILLERS REMARKS:

If well telescopes please sketch and show depths.

GROUND LEVEL

			6

SECTION 7

Please indicate well location X.

ADDITIONAL INFORMATION

If more than one screen, show locations of each on sketch.