

CODEN

Location secured 11/15/69 Jek

MISSISSIPPI BOARD OF WATER COMMISSIONERS  
416 North State Street  
Jackson, Mississippi 39201

CODEN

WATER WELL DRILLERS LOG

PIKE  
K 22  
9-26-68

9-26-1968 date well completed  
annette pump & well supply firm name  
PIKE county well located

LANDOWNER: L.P. Ford Jr.  
R 3 Box 18  
Magnolia Miss  
(mailing address)

description of formations encountered	from	to
Clay	0	200
fine sand	200	290
course sand	290	305


WELL LOCATION:  
sec 3 T 1 N R 7 E  
5 miles South Magnolia  
(distance) (direction) (nearest town)

WELL PURPOSE: Home  
(home, irrigation, municipal, industrial)

CODEN

WELL COMPLETION DATA:


- (1) diameter (inches) 4"
- (2) total depth (feet) 305'
- (3) static water level (feet) 40' below top of ground.
- (4) casing 4" PL 295'  
(material) (depth)  
(size) if telescope see back.
- (5) screen 10' 295'  
(length) (depth to top)  
4" PVC  
(size) (material)
- (6) pump 1/2 HP 12 GPM  
(HP) (yield gpm)  
Electric  
(type power)
- (7) electric log NO  
(yes or no)  
(organization running log)
- (8) how well bottom plugged  
Treated wood plug

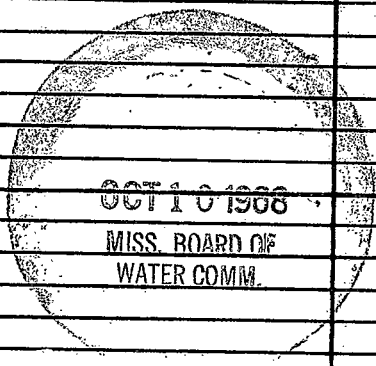

DRILLERS REMARKS:

If well telescopes please sketch and show depths.

GROUND LEVEL

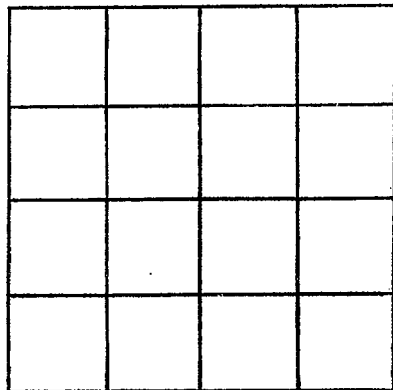

SECTION \_\_\_\_\_

Please indicate well location X.

ADDITIONAL INFORMATION

If more than one screen, show locations of each on sketch.