

Dike  
K 23  
4-11-69

MISSISSIPPI  
BOARD OF WATER COMMISSIONERS  
416 North State Street  
Jackson, Mississippi 39201

WATER WELL DRILLERS LOG

COPIED

4-11 1969  
date well completed

Fitzgould well drill  
firm name

Rice  
county well located

LANDOWNER:

A.E. Ott

R.R. Osypa Miss.  
(mailing address)

description of formations  
encountered

from to

Red clay 0 20  
Red sand 20 40  
Coarse sand & gravel 40 128

WELL LOCATION:

sec. ~~20~~ T ~~2~~ N R ~~8~~ E  
27 1 S 57 W  
1 miles W of Osypa  
(distance) (direction) (nearest town)

WELL PURPOSE:

Home  
(home, irrigation, municipal, industrial)

WELL COMPLETION DATA:

- (1) diameter (inches) 4
- (2) total depth (feet) 128
- (3) static water level (feet) 85 below top of ground.
- (4) casing Plastic, 122, (material) (depth)  
4 (size) if telescope see back.
- (5) screen 6 (length), 122 (depth to top)  
4 (size), Plastic (material)
- (6) pump 1/2 (HP), 10 (yield gpm)  
Elec (type power)
- (7) electric log no (yes or no)  
(organization running log)
- (8) how well bottom plugged to head


DRILLERS REMARKS:

NOV 28 1969

MISS. Bd. of  
WATER COMMISSIONERS

If well telescopes please sketch and show depths.

GROUND LEVEL

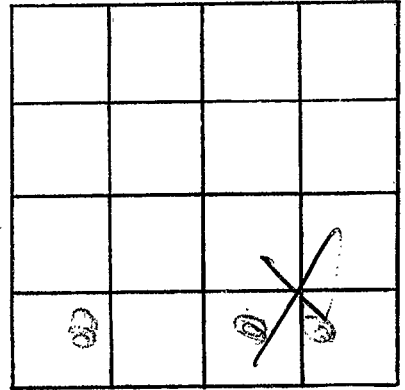

SECTION 27

Please indicate well location X.

ADDITIONAL INFORMATION

If more than one screen, show locations of each on sketch.