

Pike
K 29
4-24-69

MISSISSIPPI
 BOARD OF WATER COMMISSIONERS
 416 North State Street
 Jackson, Mississippi 39201

CODED

WATER WELL DRILLERS LOG

4-24 19 69 Amite Pump & Well Pike
 date well completed firm name county well located

LANDOWNER: Thomas Wilson

description of formations encountered

from to

R 2

clay

0 80

Oxyha Miss
 (mailing address)

SAND & GRAVEL

80 114

WELL LOCATION:

sec. 30 T 1 N R 7 E
 S W
4 miles W. of Oxyha
 (distance) (direction) (nearest town)

WELL PURPOSE:

(home, irrigation, municipal, industrial)

WELL COMPLETION DATA:

- (1) diameter (inches) 4"
- (2) total depth (feet) 114'
- (3) static water level (feet) 90 below above top of ground.
- (4) casing 4" PVC 104'
 (material) (depth)

 If telescope see back.
 (size)

- (5) screen 10' 104'
 (length) (depth to top)

4" PVC
 (size) (material)

- (6) pump 3/4 6
 (HP) (yield gpm)

Elect.
 (type power)

- (7) electric log no.
 (yes or no)

 (organization running log)

- (8) how well bottom plugged wood

DRILLERS REMARKS:


CODED

APR 29 1969

MISS. DEPT. OF
 WATER CONTROL

If well telescopes please sketch and show depths.

GROUND LEVEL

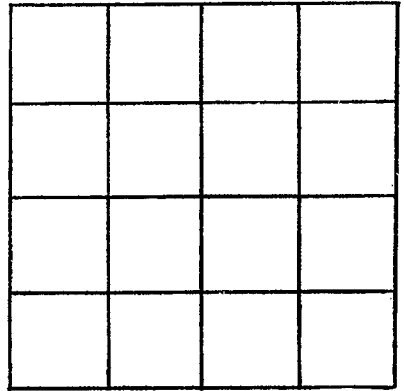

SECTION 30

Please indicate well location X.

ADDITIONAL INFORMATION

If more than one screen, show locations of each on sketch.