

Pike
K 26
7-69

MISSISSIPPI
BOARD OF WATER COMMISSIONERS
416 North State Street
Jackson, Mississippi 39201

WATER WELL DRILLERS LOG

7-5 1969 *Fitzgerald Well Drilling* *Pike*
date well completed firm name county well located

LANDOWNER:
Walter Fugua
R.R. Oseyhman
(mailing address)

description of formations encountered	from	to
<i>Red clay</i>	0	20
<i>Red sand</i>	20	80
<i>Red gravel</i>	80	115
<i>Coarse sand & gravel</i>	115	126

WELL LOCATION:
sec. 1 T. 10 N. R. 7 E
S. W.
4 miles S of Mac
(distance) (direction) (nearest town)

WELL PURPOSE: Home
(home, irrigation, municipal, industrial)


- WELL COMPLETION DATA:
- (1) diameter (inches) 4
 - (2) total depth (feet) 126
 - (3) static water level (feet) 75 below above top of ground.
 - (4) casing 4 120
(material) (depth)
4 if telescope see back.
(size)
 - (5) screen 6 120
(length) (depth to top)
4 plastic
(size) (material)
 - (6) pump ? ?
(HP) (yield gpm)
Elco
(type power)
 - (7) electric log no
(yes or no)
(organization running log)
 - (8) how well bottom plugged wood plug

DRILLERS REMARKS:

GUIDED
APR 4 1969
MISS. BD. OF WATER COMMISSIONERS

If well telescopes please sketch and show depths.

GROUND LEVEL

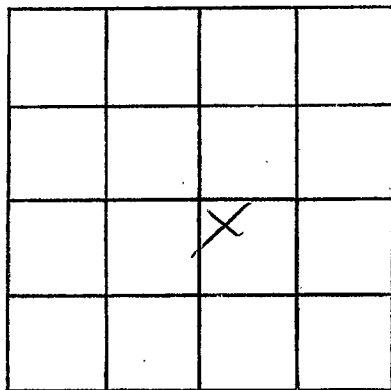

SECTION 1

Please indicate well location X.

ADDITIONAL INFORMATION

If more than one screen,
show locations of each on sketch.