

Pike
K 27
6-4-69

MISSISSIPPI
BOARD OF WATER COMMISSIONERS
416 North State Street
Jackson, Mississippi 39201

CODED

WATER WELL DRILLERS LOG

6-4 1969 Amite Pump & Well Pike
date well completed firm name county well located

LANDOWNER: Elvira Harrison
11231 Robin Hood
Baton Rouge La
(mailing address)

description of formations encountered	from	to
clay	0	60
SAND	60	115
Gravel & SAND	115	135

WELL LOCATION:
sec. 9 T. 1 N. R. 7 E.
S. W.
2 miles W of Chattawa
(distance) (direction) (nearest town)

WELL PURPOSE:
(home, irrigation, municipal, industrial)

- WELL COMPLETION DATA:
- diameter (inches) 4"
 - total depth (feet) 135
 - static water level (feet) 75' below top of ground.
 - casing PVC, 125'
(material) (depth)
4" If telescope see back.
(size)
 - screen 10', 125'
(length) (depth to top)
4", PVC
(size) (material)
 - pump 3/4 Subm, 15 GPM
(HP) (yield gpm)
Elect.
(type power)
 - electric log no
(yes or no)
 - how well bottom plugged wood

CODED


JUN 9 - 1969

DRILLERS REMARKS:

REC. BY DE
WATER COMM

If well telescopes please sketch and show depths.

GROUND LEVEL

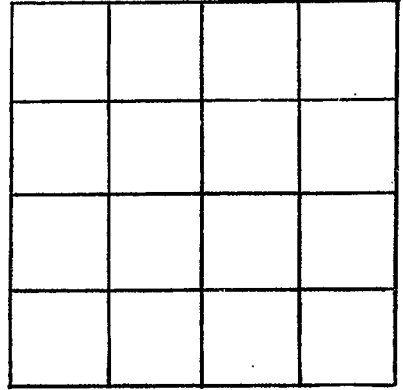

SECTION 9

Please indicate well location X.

ADDITIONAL INFORMATION

If more than one screen, show locations of each on sketch.