

E-log #116

CODED

Pike Co
K 28
4-70

MISSISSIPPI
BOARD OF WATER COMMISSIONERS
416 North State Street
Jackson, Mississippi 39201

WATER WELL DRILLERS LOG

April 19 70 Eriner Drilling Service, Inc Pike
date well completed firm name county well located

LANDOWNER: Town of

OSYKA

description of formations encountered

from to

Top Soil	0	2
Sand & Gravel	2	87
Clay	87	95
Sand & Gravel	95	176
Clay	176	190
Sand & Gravel	190	260

(mailing address)

WELL LOCATION:

sec. 35 T 11 N R 7E
S W

miles of (distance) (direction) (nearest town)

WELL PURPOSE: Municipal
(home, irrigation, municipal, industrial)

WELL COMPLETION DATA:

- (1) diameter (inches) 8x6
- (2) total depth (feet) 240
- (3) static water level (feet) 38' below top of ground.
- (4) casing Steel, 190'
(material) (depth)
8"
(size) If telescope see back.
- (5) screen 40', 200'
(length) (depth to top)
6", S.S.
(size) (material)
- (6) pump 20, 200
(HP) (yield gpm)
Electric
(type power)
- (7) electric log yes
(yes or no)
MGS
(organization running log)
- (8) how well bottom plugged Back
Wash Drive

CODED

APR 23 1970


DRILLERS REMARKS:

MISS. BD. OF
WATER COM.

①

If well telescopes please sketch and show depths.

GROUND LEVEL

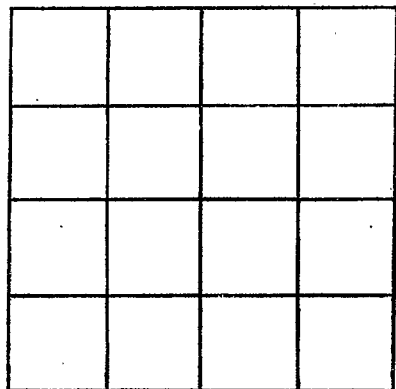

SECTION _____

Please indicate well location X.

ADDITIONAL INFORMATION

If more than one screen, show locations of each on sketch.