

Pike Co  
 K 29  
 4-3-70

MISSISSIPPI  
 BOARD OF WATER COMMISSIONERS  
 416 North State Street  
 Jackson, Mississippi 39201

WATER WELL DRILLERS LOG

April 3 1970 Chester Kemes Pike  
 (date well completed) (firm name) (county well located)

LANDOWNER: Oliver Ross  
 RFD, Magnolia (mailing address)  
 WELL LOCATION:  
 sec. 1 T. 1 N. R. 1 E 065  
 5 miles S Magnolia (distance) (direction) (nearest town)  
 WELL PURPOSE: Home (home, irrigation, municipal, industrial)

description of formations encountered	from	to
clay	0	18
Red sandy clay	18	65
Sand & gravel	65	90
Red chalk	90	104
Coarse sand	104	118

WELL COMPLETION DATA:

- (1) diameter (inches) 4"
- (2) total depth (feet) 118
- (3) static water level (feet) 63 below top of ground.
- (4) casing Washer Bottom (material) (depth)
- (size) if telescope see back.
- (5) screen 6' (length) 117' (depth to top)  
 45' (size) Plastic (material)
- (6) pump 1/2 Sub 12 (HP) (yield gpm)  
 Elect (type power)
- (7) electric log No - (yes or no)

(organization running log)

(8) how well bottom plugged  
 wooden plug


MAY 1 1970

DRILLERS REMARKS:  
 new house.

MISS. BD. OF  
 WATER COMMISSIONERS

If well telescopes please sketch and show depths.

GROUND LEVEL

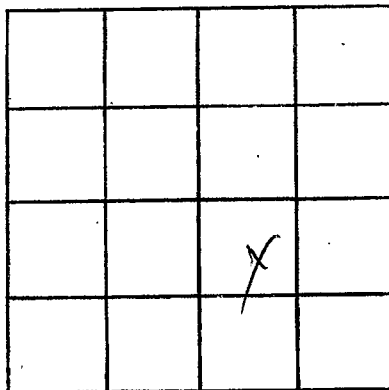

SECTION 1

Please indicate well location X.

ADDITIONAL INFORMATION

If more than one screen, show locations of each on sketch.