

Pike Co
K 30
4-24-70

MISSISSIPPI
BOARD OF WATER COMMISSIONERS
416 North State Street
Jackson, Mississippi 39201

WATER WELL DRILLERS LOG

April 24 1970 Chester Keens Pike
date well completed firm name county well located

LANDOWNER: Richard
Elston
RFD, Osyka
(mailing address)

WELL LOCATION:
sec 27 T 10 N R 7 E 065
1 1/2 miles W Osyka
(distance) (direction) (nearest town)

WELL PURPOSE: Home
(home, irrigation, municipal, industrial)

WELL COMPLETION DATA:
(1) diameter (inches) 4"
(2) total depth (feet) 137
(3) static water level (feet) 94 below top of ground.
(4) casing (material) (depth) (size) if telescope see back.
Plastic Bottom
(5) screen 6' 131" (length) (depth to top)
4" Plastic (size) (material)
(6) pump 3/4 Sub 12 (HP) (yield gpm)
ELECT (type power)
(7) electric log No. (yes or no)
(organization running log)

(8) how well bottom plugged
wooden plug
DRILLERS REMARKS:
New Gause!


description of formations encountered	from	to
bed clay	0	22
bed sandstone		
disconformity	22	45
gravel & sand	45	116
bed cherty sand	116	126
small gravel sand	126	137

MAY 14 1970

MISS. Bd. OF WATER COMM.

If well telescopes please sketch and show depths.

GROUND LEVEL

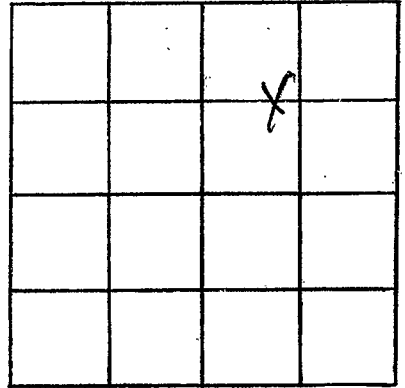

SECTION 27

Please indicate well location X.

ADDITIONAL INFORMATION

If more than one screen,
show locations of each on sketch.