

**MISSISSIPPI  
BOARD OF WATER COMMISSIONERS**  
416 North State Street  
Jackson, Mississippi 39201

**Pike Co**  
**K 31**  
**5-14-70**

3 BC WATER WELL DRILLERS LOG

14 May 1970 date well completed      J.T. Covington firm name      Pike county well located

**LANDOWNER:**  
Dick Alfred  
Osgood, Miss.  
(mailing address)

**WELL LOCATION:** 168  
sec. 20 T. 1 N. R. 7 E.  
3 miles west of Osgood  
(distance) (direction) (nearest town)

description of formations encountered	from	to
Clay	0	10
Clay sand	10	30
Sand chalk	20	30
Sand	30	45
Sand chalk	45	60
Chalk	60	190
Chalk sand	190	210
Sand	210	254

**WELL PURPOSE:** Home  
(home, irrigation, municipal, industrial)

**WELL COMPLETION DATA:**

(1) diameter (inches) 4

(2) total depth (feet) 254

(3) static water level (feet) 25 Below top of ground.

(4) casing 2 1/2" (material) 248 (depth)

(size) if telescope see back.

(5) screen 4' (length) 248 (depth to top)

4" (size) 1" (material)

(6) pump 3/4 (HP) 15 (yield gpm)

Elect. (type power)

(7) electric log (yes or no)

(organization running log)

(8) how well bottom plugged Wood


MAY 5 1970

**DRILLERS REMARKS:**

MISS. BD. OF  
WATER COMM.

If well telescopes please sketch and show depths.

GROUND LEVEL

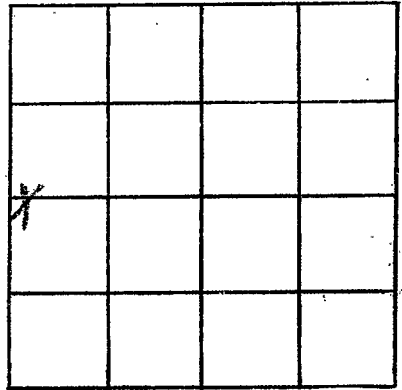

SECTION 20

Please indicate well location X.

ADDITIONAL INFORMATION

If more than one screen,  
show locations of each on sketch.