

PIKE
K 32
6-30-70

MISSISSIPPI
BOARD OF WATER COMMISSIONERS
416 North State Street
Jackson, Mississippi 39201

CODED

WATER WELL DRILLERS LOG

June 30, 1970 date well completed
Chester Keene firm name
Pike county well located

LANDOWNER: Bill Carter

description of formations encountered

from

to

RFD Oxyka

(mailing address)

sandy clay 00 18
red sand 18 30
white sand
pea gravel 30 42

WELL LOCATION:

sec. 20 T-1 N 2 E
3 miles NW of Oxyka
(distance) (direction) (nearest town)

WELL PURPOSE: house
(home, irrigation, municipal, industrial)

WELL COMPLETION DATA:

- (1) diameter (inches) 4 1/2"
- (2) total depth (feet) 42
- (3) static water level (feet) 19 below top of ground. above
- (4) casing Plastic Galvan
(material) (depth)

CODED

- (5) screen 6' 36'
(length) (depth to top)
- 4" Plastic
(size) (material)

- (6) pump 4 1/2 HP 15
(HP) (yield gpm)
- elect
(type power)

- (7) electric log no
(yes or no)

(organization running log)

- (8) how well bottom plugged wooden plug


DRILLERS REMARKS:

SEP 15 1970

MISS. BD. OF
WATER COMM.

If well telescopes please sketch and show depths.

GROUND LEVEL

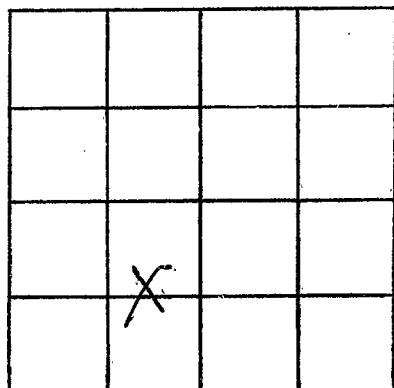

SECTION 20

Please indicate well location X.

ADDITIONAL INFORMATION

If more than one screen,
show locations of each on sketch.