

MISSISSIPPI
BOARD OF WATER COMMISSIONERS
416 North State Street
Jackson, Mississippi 39201

CODED

WATER WELL DRILLERS LOG

PIKE
K 34
8-26-70

8-26
date well completed

1970 *F. J. ...*
firm name

Pike
county well located

LANDOWNER:

Bernard ...

description of formations encountered

from to

R.R. ...
(mailing address)

Red clay 0 12
White clay 12 45
Coarse sand 45 66

WELL LOCATION:

sec. *3* T *1* N R *7* E
S W
4 miles *N* of *Orytha*
(distance) (direction) (nearest town)

WELL PURPOSE: *Home*
(home, irrigation, municipal, industrial)

WELL COMPLETION DATA:

- (1) diameter (inches) *4*
- (2) total depth (feet) *66*
- (3) static water level (feet) *20* below top of ground.
- (4) casing *Plate*, *60*
(material) (depth)
4 if telescope see back.
(size)
- (5) screen *6*, *60*
(length) (depth to top)
4, *Plate*
(size) (material)
- (6) pump *3/4*, *8*
(HP) (yield gpm)
Electric
(type power)
- (7) electric log *Yes*
(yes or no)
...
(organization running log)
- (8) how well bottom plugged *Good*


CODED

SEP 14 1970

DRILLERS REMARKS:

If well telescopes please sketch and show depths.

GROUND LEVEL

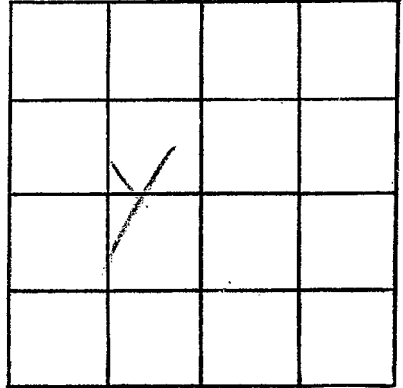

SECTION 2

Please indicate well location X.

ADDITIONAL INFORMATION

If more than one screen,
show locations of each on sketch.