

PIKE

K35

8-21-70

MISSISSIPPI BOARD OF WATER COMMISSIONERS
416 North State Street
Jackson, Mississippi 39201

CODED

WATER WELL DRILLERS LOG

Aug 21 1970 Chester Keane Pike
date well completed firm name county well located

LANDOWNER: Enforcement

description of formations encountered

from

to

R+3

Magnolia
(mailing address)

Red Sandy Clay

0 27

Red Sand

27 60

Sandy Sand

60 94

Sand Rock

94 94

Chalk

94 127

Fine Sand

127 155

Coarse Sand

155 175

Gravel

155 175

WELL LOCATION:

sec. 10 T. 11 N. R. 7 E. W
3/4 miles NNW of Oxford
(distance) (direction) (nearest town)

WELL PURPOSE: Home
(home, irrigation, municipal, industrial)

WELL COMPLETION DATA:

(1) diameter (inches) 4"

(2) total depth (feet) 175

(3) static water level (feet) 23 below top of ground.

(4) casing Plastic Bottom
(material) (depth)

(size) if telescope see back.

(5) screen 6' 169'
(length) (depth to top)

4" Plastic
(size) (material)

(6) pump 1/2 HP 12
(HP) (yield gpm)

2400
(type power)

(7) electric log No
(yes or no)

(organization running log)

(8) how well bottom plugged water plug

DRILLERS REMARKS: old 2" well bad


CODED

SEP 21 1970

MISS. Bd. of Water Comm. 1968

If well telescopes please sketch and show depths.

GROUND LEVEL

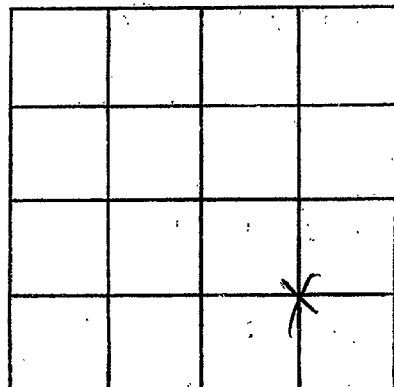

SECTION 18

Please indicate well location X.

ADDITIONAL INFORMATION

If more than one screen,
show locations of each on sketch.