

Pike
K36
5-12-70

MISSISSIPPI
BOARD OF WATER COMMISSIONERS
416 North State Street
Jackson, Mississippi 39201

CODED

WATER WELL DRILLERS LOG

May 12 1970 Chester Keenes
date well completed firm name county well located

LANDOWNER: David

Strived
Maple
(mailing address)

WELL LOCATION:

sec 3 T 1 N R 7 E
4 1/2 miles S SW Maple
(distance) (direction) (nearest town)

WELL PURPOSE: Home
(home, irrigation, municipal, industrial)

WELL COMPLETION DATA:

- (1) diameter (inches) 4"
- (2) total depth (feet) 339
- (3) static water level (feet) 62 below above top of ground.
- (4) casing Plastic bottom
(material) (depth)
- (size) if telescope see back.
- (5) screen 10' 339
(length) (depth to top)
4" Plastic
(size) (material)
- (6) pump 1/2 HP 175
(HP) (yield gpm)
select.
(type power)
- (7) electric log NO
(yes or no)

(organization running log)

(8) how well bottom plugged
wandering

DRILLERS REMARKS:
new location

description of formations encountered

from to

Red clay	0	8
Red sand gravel	8	68
Blue chalk	68	130
fine sand	130	180
hard blue chalk	180	310
Coarse sand	310	339


CODED

III 24 1970

MISS. BD. OF
WATER COM.

If well telescopes please sketch and show depths.

GROUND LEVEL

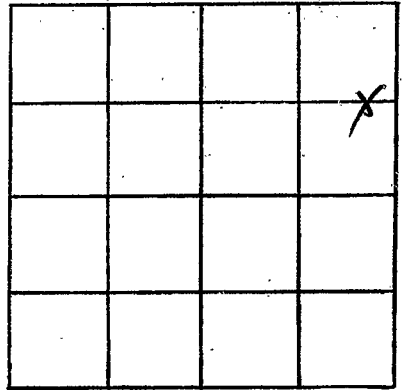

SECTION 3

Please indicate well location X.

ADDITIONAL INFORMATION

If more than one screen,
show locations of each on sketch.