

Pike
K 37
6-4-70

MISSISSIPPI
BOARD OF WATER COMMISSIONERS
416 North State Street
Jackson, Mississippi 39201

CODED

WATER WELL DRILLERS LOG

6-4 date well completed 19 70 firm name Fitzgerald Well Serv county well located Pike

LANDOWNER:
Myrtle Kupper
P.O. Osyka Miss.
(mailing address)

description of formations encountered	from	to
Red Clay	0	15
Red Sand	15	60
Red gravel	60	80
Red Stone	80	105
Coarse Sand & gravel	105	114

WELL LOCATION:
sec. 34 T 1 N R 7 W
1/2 miles W of Osyka
(distance) (direction) (nearest town)

WELL PURPOSE: Home
(home, irrigation, municipal, industrial)

- WELL COMPLETION DATA:
- (1) diameter (inches) 4
 - (2) total depth (feet) 114
 - (3) static water level (feet) 82 below top of ground.
 - (4) casing (material) Plastic, (depth) 106.
4 (size) if telescope see back.
 - (5) screen (length) 8 (depth to top) 106
4 (size) Plastic (material)
 - (6) pump (HP) 3/4 (yield gpm) 6
6 hp (type power)
 - (7) electric log (yes or no) Yes
 - (8) how well bottom plugged completely

CODED


MAY 29 1970

DRILLERS REMARKS:

MISS. BD. OF
WATER COMMISSIONERS

If well telescopes please sketch and show depths.

GROUND LEVEL

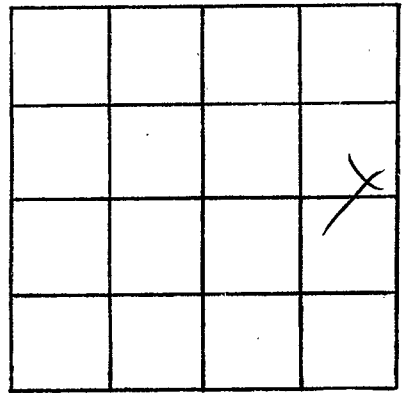

SECTION 34

Please indicate well location X.

ADDITIONAL INFORMATION

If more than one screen, show locations of each on sketch.