

Pike  
K 38  
7-1-70

MISSISSIPPI  
BOARD OF WATER COMMISSIONERS  
416 North State Street  
Jackson, Mississippi 39201

WATER WELL DRILLERS LOG

**CODED**

7-1 1970 date well completed  
Fitzgerald Well Drilling firm name  
Pike county well located

LANDOWNER:  
Homer Adelson  
RR Ozyka Miss.  
(mailing address)

description of formations encountered	from	to
Red clay	6	20
Red sand	20	80
Coarse sand gravel	80	108

WELL LOCATION:  
sec. 38 T. 1 N. R. 7 E  
3 miles WNW of Ozyka  
(distance) (direction) (nearest town)

WELL PURPOSE: Home  
(home, irrigation, municipal, industrial)

- WELL COMPLETION DATA:
- (1) diameter (inches) 4
  - (2) total depth (feet) 101
  - (3) static water level (feet) 80 below above top of ground.
  - (4) casing plastic 93, (material) (depth)  
4 (size) if telescope see back.
  - (5) screen 8, 93 (length) (depth to top)  
4 (size) plastic (material)
  - (6) pump 1, 6 (HP) (yield gpm)  
elm (type power)
  - (7) electric log yes (yes or no)  
(organization running log)
  - (8) how well bottom plugged coal py

**CODED**


NOV 24 1970

MISS. BD. OF WATER COMM.

DRILLERS REMARKS:

If well telescopes please sketch and show depths.

GROUND LEVEL

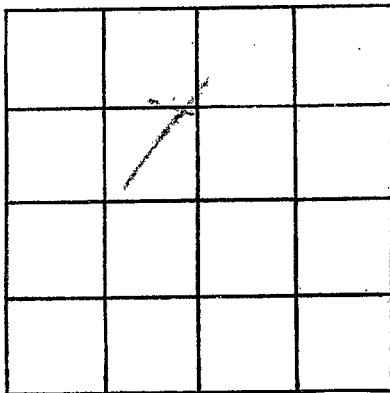

SECTION 28

Please indicate well location X.

ADDITIONAL INFORMATION

If more than one screen, show locations of each on sketch.