

PIKE

K 39

8-1-70

MISSISSIPPI
 BOARD OF WATER COMMISSIONERS
 416 North State Street
 Jackson, Mississippi 39201

CODED

WATER WELL DRILLERS LOG

R-1
date well completed

1970 Amite Pump & Well
firm name

pike
county well located

LANDOWNER: John Tenair

R 3 Box 45

Magnolia Miss
(mailing address)

description of formations encountered

from

to

clay	0	70
SAND	70	100
hard gravel	100	117

WELL LOCATION:

sec 22 T 1 N R 7 E
 2 miles n.w. of Oryka
 (distance) (direction) (nearest town)

WELL PURPOSE: home
(home, irrigation, municipal, industrial)

WELL COMPLETION DATA:

- (1) diameter (inches) 4"
- (2) total depth (feet) 117
- (3) static water level (feet) 80 below above top of ground.
- (4) casing PL 107'
(material) (depth)
4" If telescope see back.
(size)
- (5) screen 10' 107'
(length) (depth to top)
4" PLC
(size) (material)
- (6) pump 10 10
(HP) (yield gpm)
Elect
(type power)
- (7) electric log NO
(yes or no)

CODED

(organization running log)

(8) how well bottom plugged wood


AUG 6 1970

DRILLERS REMARKS:

MISS. DEPT. OF
WATER RESOURCES

If well telescopes please sketch and show depths.

GROUND LEVEL

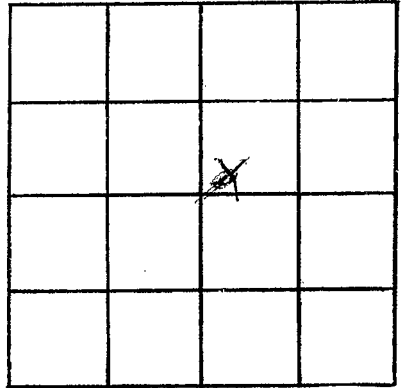

SECTION 22

Please indicate well location X.

ADDITIONAL INFORMATION

If more than one screen,
show locations of each on sketch.