

PIKE
K 40
11-18-70

MISSISSIPPI
BOARD OF WATER COMMISSIONERS
416 North State Street
Jackson, Mississippi 39201

CODED

WATER WELL DRILLERS LOG

11-18 date well completed 19 72 Fatgood Well Dr firm name Pike county well located

LANDOWNER:
Sylvester Carmel
RR. Magnolia Miss.
(mailing address)

description of formations encountered	from	to
<u>Red Clay</u>	<u>0</u>	<u>20</u>
<u>Red Sand</u>	<u>20</u>	<u>80</u>
<u>Red gravel</u>	<u>80</u>	<u>100</u>
<u>Coarse sand & gravel</u>	<u>100</u>	<u>118</u>

WELL LOCATION:
sec. 13T-1 N R. 2 E
5 miles S of Magnolia
(distance) (direction) (nearest town)

WELL PURPOSE: Home
(home, irrigation, municipal, industrial)

- WELL COMPLETION DATA:
- (1) diameter (inches) 4
 - (2) total depth (feet) 118
 - (3) static water level (feet) 20 below top of ground.
 - (4) casing plastic, 112,
(material) (depth)
4 if telescope see back.
(size)
 - (5) screen 6, 112
(length) (depth to top)
4, plastic
(size) (material)
 - (6) pump 1, 6
(HP) (yield gpm)
60
(type power)
 - (7) electric log no
(yes or no)
(organization running log)
 - (8) how well bottom plugged completely

CODED


DRILLERS REMARKS:

DEC 17 1970

MISS. R.D. #1
WATER BOARD

If well telescopes please sketch and show depths.

GROUND LEVEL

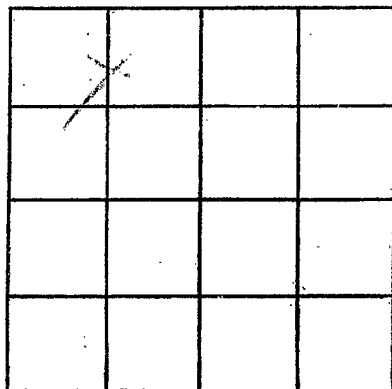

SECTION 12

Please indicate well location X:

ADDITIONAL INFORMATION

If more than one screen,
show locations of each on sketch.