

MISSISSIPPI
BOARD OF WATER COMMISSIONERS
416 North State Street
Jackson, Mississippi 39201

CODED

WATER WELL DRILLERS LOG

PIKE
K 41
11-28-70

Nov. 28 1970 date well completed
Chester Keener firm name
Pike county well located

LANDOWNER: Will Hays

RFD Cayton

(mailing address)

WELL LOCATION:

sec 20 T 1 N R 7 E

(distance) miles (direction) of (nearest town)

WELL PURPOSE: Home (home, irrigation, municipal, industrial)

WELL COMPLETION DATA:

- (1) diameter (inches) 4"
- (2) total depth (feet) 117
- (3) static water level (feet) 24 below top of ground.
- (4) casing (material) (depth) Plastic Bottom
- (5) screen (size) (length) (depth to top) 6' 106
- (6) pump (HP) (yield gpm) 1/2 12
- (7) electric log (yes or no) No

(organization running log)

(8) how well bottom plugged Woodruff

DRILLERS REMARKS: New hand

description of formations encountered

from to

clay	0	12
sand	12	20
chalk	20	35
chalky sand	35	55
chalk	55	70
sand & gravel	70	95
chalky gravel	95	100
gravel	100	117


CODED

FEB 4 1971

MISS. BD. OF WATER COMMISSIONERS

If well telescopes please sketch and show depths.

GROUND LEVEL

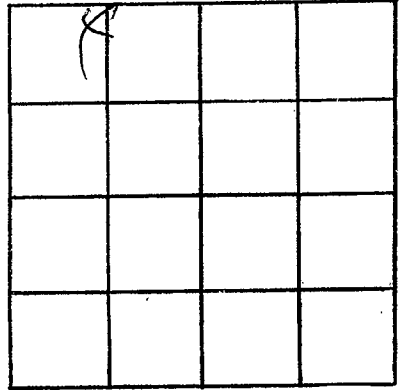

SECTION 70

Please indicate well location X.

ADDITIONAL INFORMATION

If more than one screen, show locations of each on sketch.