

Pido
K 49
8-29-69

MISSISSIPPI
BOARD OF WATER COMMISSIONERS
416 North State Street
Jackson, Mississippi 39201

CODED

WATER WELL DRILLERS LOG

29 Aug 1969 date well completed
J. T. Carney firm name
P. K. L. county well located

LANDOWNER:
Dick Alfred
Osyka (mailing address)

description of formations encountered	from	to
Clay	0	15
clay sand	15	30
good sand	30	60

WELL LOCATION:
sec. 20 T-1 N R-7 E
4 miles west of Osyka (distance) (direction) (nearest town)

WELL PURPOSE:
(home, irrigation, municipal, industrial)

- WELL COMPLETION DATA:
- (1) diameter (inches) 4 1/2
 - (2) total depth (feet) 60
 - (3) static water level (feet) 20 below top of ground
 - (4) casing (material) PL (depth) 60
4 1/2 (size) if telescope see back.
 - (5) screen (length) 20 (depth to top) 50
4 (size) PL (material)
 - (6) pump (HP) 1 (yield gpm) 6
Electric (type power)
 - (7) electric log (yes or no)
 - (8) how well bottom plugged used

CODED


OCT 15 1969

MISS. BD. OF
WATER COMM.

DRILLERS REMARKS:

If well telescopes please sketch and show depths.

GROUND LEVEL

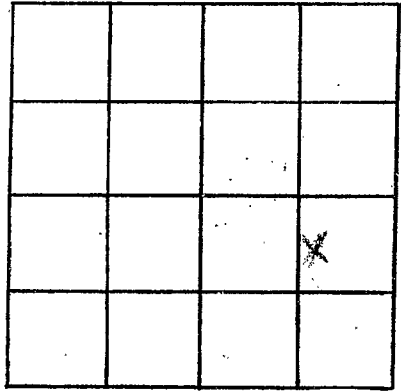

SECTION 20

Please indicate well location X.

ADDITIONAL INFORMATION

If more than one screen,
show locations of each on sketch.