

PIKE
 R 46
 12-19-69

MISSISSIPPI
 BOARD OF WATER COMMISSIONERS
 416 North State Street
 Jackson, Mississippi 39201

CODED

WATER WELL DRILLERS LOG

Dec 19 69 Kelso Well Drillers Pike
 date well completed firm name county well located

LANDOWNER: James Byrd
RFD Maple Ridge

description of formations encountered from to

(mailing address)

Red clay 0 12

WELL LOCATION:
 sec. 9 T 1 N R 7 E
1 miles W Chattanooga
 (distance) (direction) (nearest town)

Red sand & blue clay 12 90
Sand & gravel 90 96
Sandy & gravelly 96 182

WELL PURPOSE: Home
 (home, irrigation, municipal, industrial)

Light

WELL COMPLETION DATA:

finely coarse

(1) diameter (inches) 1 1/2"

pink sand 182 200

(2) total depth (feet) 200

(3) static water level (feet) 91 below above top of ground.

(4) casing Plastic Bottom
 (material) (depth)

(5) screen 6' 194'
 (length) (depth to top)

(6) pump 1 HP Jet - 6
 (HP) (yield gpm)

glect
 (type power)

(7) electric log No
 (yes or no)

(organization running log)

(8) how well bottom plugged wooden plug

DRILLERS REMARKS:
No previous well


CODED

FORM - 9 10/70

ISS. ED. OF
 WATER COMM.

If well telescopes please sketch and show depths.

GROUND LEVEL

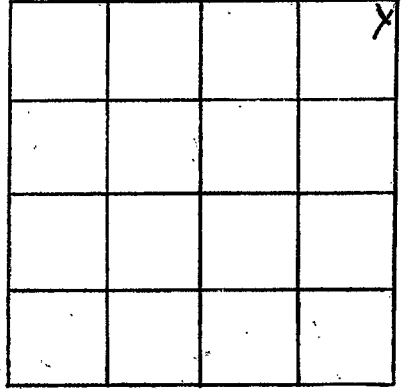

SECTION 9

Please indicate well location X.

ADDITIONAL INFORMATION

If more than one screen,
show locations of each on sketch.