

PIKE
K47
4-6-71

MISSISSIPPI
BOARD OF WATER COMMISSIONERS
416 North State Street
Jackson, Mississippi 39201

CODED

WATER WELL DRILLERS LOG

4-6 1971 Flynn & Co. Inc. Pike
date well completed firm name county well located

LANDOWNER:
W. E. Dickey
R. B. Oyster, Jr.
(mailing address)

description of formations encountered	from	to
<u>red clay</u>	<u>0</u>	<u>20</u>
<u>red sand</u>	<u>20</u>	<u>80</u>
<u>white clay</u>	<u>80</u>	<u>180</u>
<u>coarse sand & gravel</u>	<u>180</u>	<u>204</u>

WELL LOCATION:
sec. 29 T. 10 N. R. 7 E.
3 miles W of Oyster
(distance) (direction) (nearest town)

WELL PURPOSE:
Home
(home, irrigation, municipal, industrial)

- WELL COMPLETION DATA:
- (1) diameter (inches) 4
 - (2) total depth (feet) 204
 - (3) static water level (feet) 42 below above top of ground.
 - (4) casing plastic 196 (material) (depth)
4 (size) if telescope see back.
 - (5) screen 8 196 (length) (depth to top)
4 (size) plastic (material)
 - (6) pump 1/2 12 (HP) (yield gpm)
electric (type power)
 - (7) electric log no (yes or no)
(organization running log)
 - (8) how well bottom plugged completely

CODED


MAY 10 1971

MISS. BD. OF
WATER COM.

DRILLERS REMARKS:

If well telescopes please sketch and show depths.

GROUND LEVEL

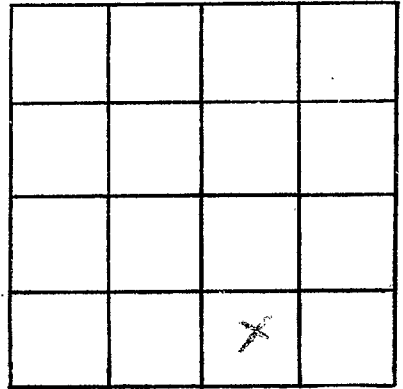

SECTION 29

Please indicate well location X.

ADDITIONAL INFORMATION

If more than one screen, show locations of each on sketch.