

PIKE  
K 48  
5-10-71

MISSISSIPPI  
BOARD OF WATER COMMISSIONERS  
416 North State Street  
Jackson, Mississippi 39201

**CODED**

WATER WELL DRILLERS LOG

5-10 date well completed 71 firm name *F. J. ...* county well located *Pike*

LANDOWNER:  
*Jackie Smith*  
*R. B. ...*  
(mailing address)

description of formations encountered	from	to
<i>Red clay</i>	<i>6</i>	<i>20</i>
<i>Red sand</i>	<i>20</i>	<i>50</i>
<i>White &amp; blue clay</i>	<i>50</i>	<i>120</i>
<i>Coarse sand &amp; gravel</i>	<i>120</i>	<i>158</i>

WELL LOCATION:  
sec. *21* T. *1* S. R. *7* E.  
*2* miles *W* of *...*  
(distance) (direction) (nearest town)

WELL PURPOSE:  
*Home*  
(home, irrigation, municipal, industrial)

- WELL COMPLETION DATA:
- (1) diameter (inches) *4*
  - (2) total depth (feet) *158*
  - (3) static water level (feet) *25* below above top of ground.
  - (4) casing *plastic, 143*,  
(material) (depth)  
*4* if telescope see back.  
(size)
  - (5) screen *15*, *143*  
(length) (depth to top)  
*4* (size) *plastic* (material)
  - (6) pump *3*, *56*  
(HP) (yield gpm)  
*elec* (type power)
  - (7) electric log *no* (yes or no)  
(organization running log)
  - (8) how well bottom plugged *...*

**CODED**


JUN 14 1971

MISS. DD. OF  
WATER COMM.

DRILLERS REMARKS:

If well telescopes please sketch and show depths.

GROUND LEVEL

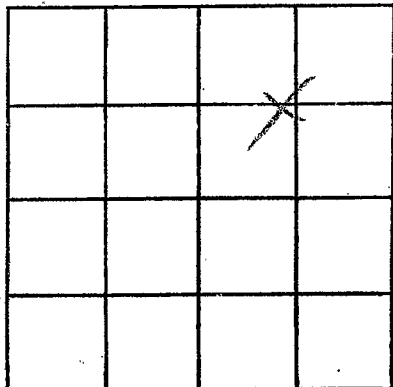

SECTION 21

Please indicate well location X.

ADDITIONAL INFORMATION

If more than one screen,  
show locations of each on sketch.